


STATE TRUNK HIGHWAY 50

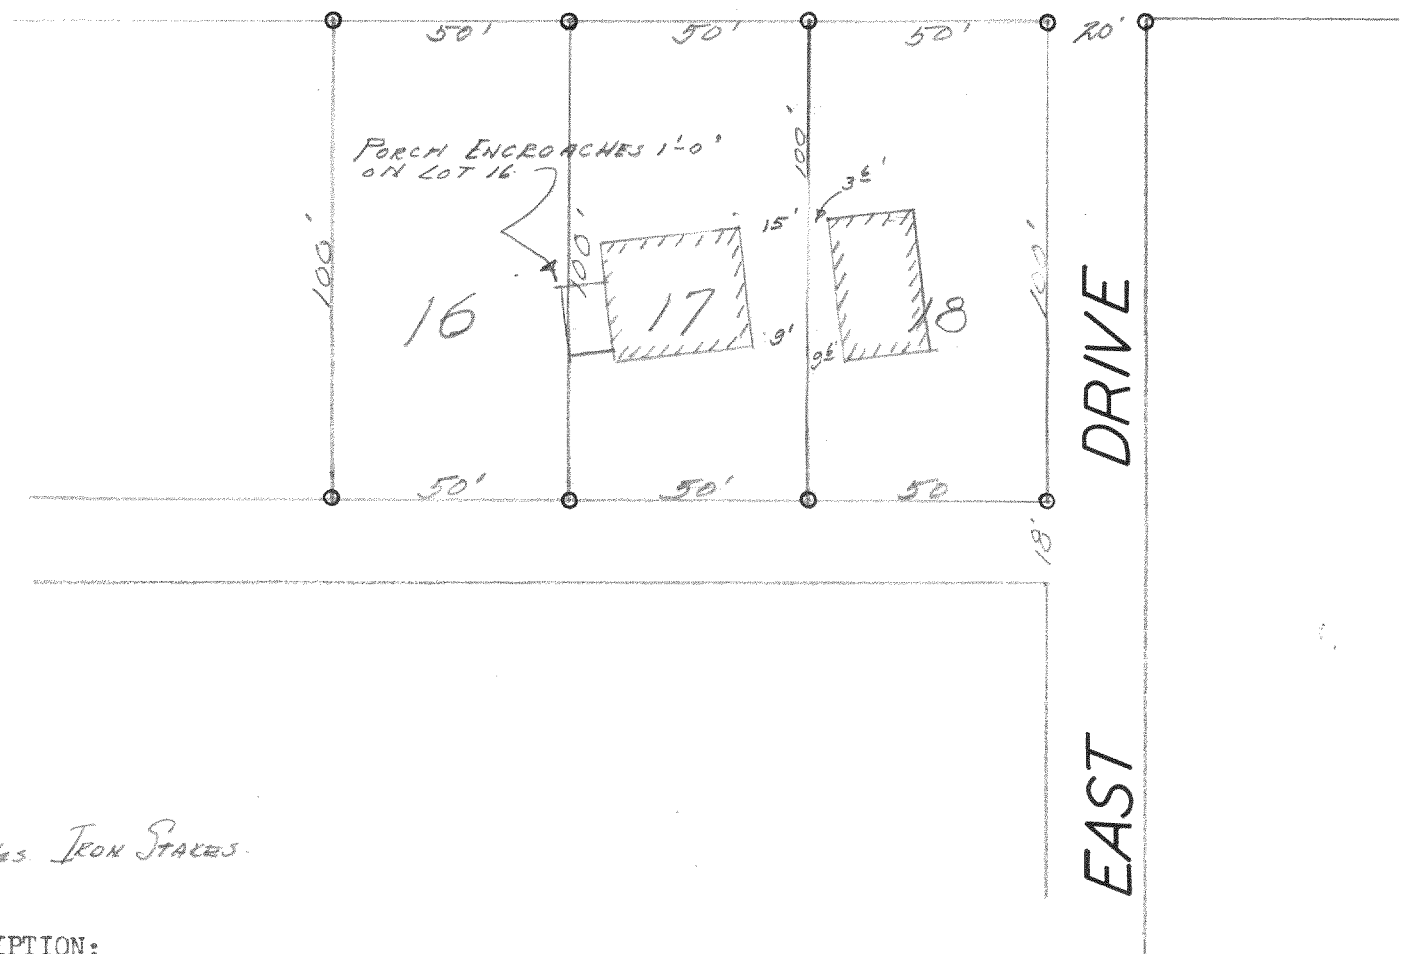

o Indicates IRON STAKES.

DESCRIPTION:

Lot 18 of Lake Geneva Golf Hills a subdivision of a portion of Section 31, Township 2 north, Range 18 east, of the 4th Principal Meridian.

CERTIFICATE: I, hereby certify that I have on this the 4th day of August 1949, surveyed the above described property according to the official records on file in the office of the Recorder of Deeds in and for Walworth County Wisconsin, and find that the measurements and bearings of the boundary lines of said property as taken at the site on this day substantially agree with those in said official record, and that no encroachments exist.

SIGNED AND SEALED THIS 5TH DAY OF AUGUST 1949.

Joseph M. Biagi
 Joseph M. Biagi. Professional Engineer.
 Elkhorn Wisconsin.