

ABERNATHY and ASSOCIATES Kenneth B. Abernathy Jr.

Wisconsin Registered Land Surveyor S-1594

Rt. 3, Box 273 Elkhorn, Wisconsin 53121 Phone: (414) 723-4260 (office) (414) 723-4813 (residence)

PLAT OF SURVEY

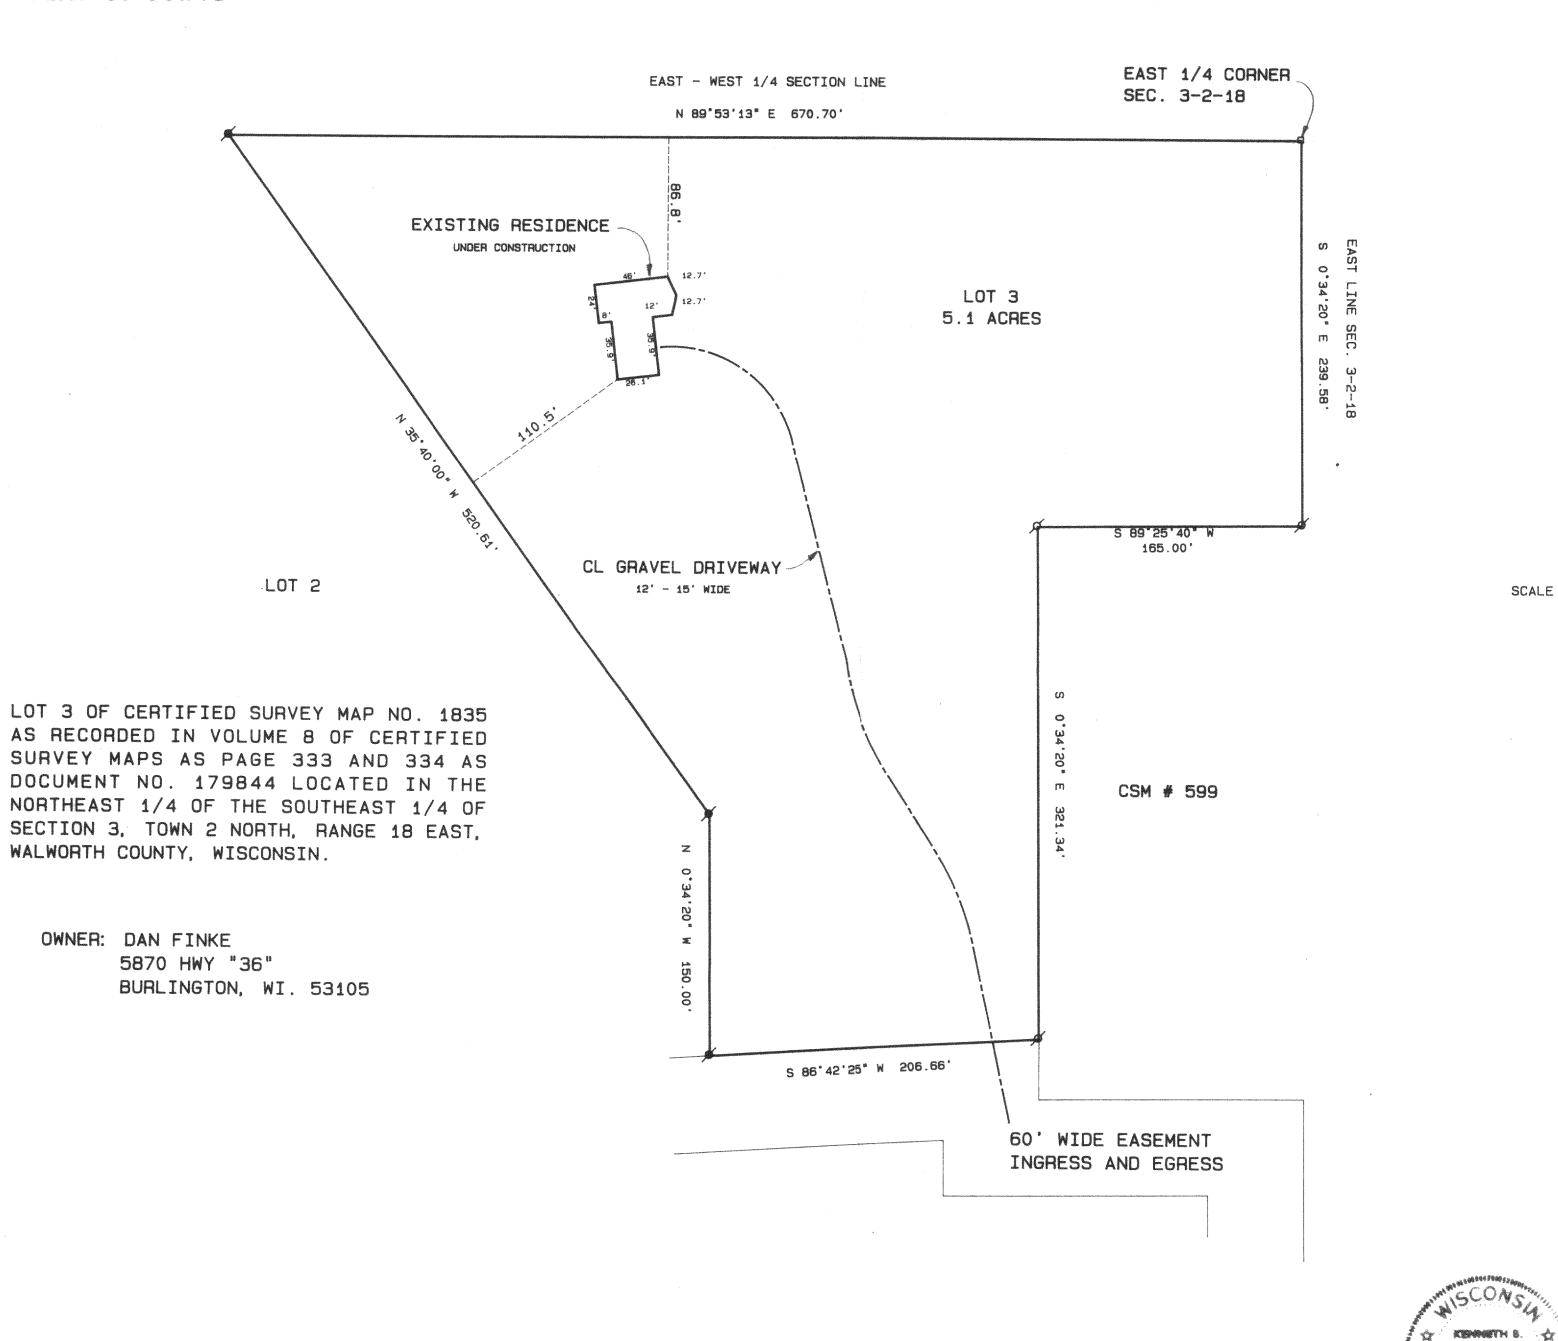

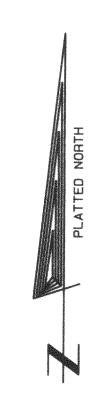

SCALE 1" = 60 FEET

Legend

FOUND IRON PIPE FOUND IRON ROD

FOUND BRASS CAPPED MONUMENT FOUND CONCRETE MONUMENT

+ CHISEL CUT IN CONCRETE

SET IRON ROD, 24" LONG, WEIGHING 1.5 LBS./LINEAL FT., 3/4" DIA.

SET IRON ROD, 30" LONG, WEIGHING

(xx) RECORDED AS DIMENSION

-x-x- EXISTING FENCE

SCALE: 1"= 60 FEET

"I hereby certify that I have surveyed the above described property and that the above map is a true representation property and that the above map is a true representation thereof and shows the size and location of the property, its exterior boundaries, the location of all visible structures and dimensions of all principal buildings thereon, boundary fences, apparent easements, roadways and visible encroach-

"This survey is made for the use of the present owners of the property, and also those who purchase, mortgage, get guarantee the title thereto withi

KENNETH B. ABERNATHY, JR. WISCONSIN REGISTERED LAND SURVEYOR,

Date: 6-3-94

ASSEMATHY, A.

\$-1594 BACHORN.

AND SURVE

