

PLAT OF SURVEY  
OF

LOT 15, BLOCK 2, FIRST ADDITION TO KNOLL BROOK, A SUBDIVISION LOCATED IN THE NORTHWEST  
1/4 OF THE SOUTHWEST 1/4 AND IN THE SOUTHWEST 1/4 OF THE SOUTHWEST 1/4 OF SECTION 10,  
T. 2 N., R. 18 E. OF THE 4TH P.M., TOWNSHIP OF LYONS, COUNTY OF WALWORTH, STATE OF WISCONSIN.


FOR: DAUFENBACH

SCALE 1" = 40'

○ = IRON PIPE STAKE

● = SOLID IRON BAR

BEARINGS REFER TO RECORDED PLAT DATUM.

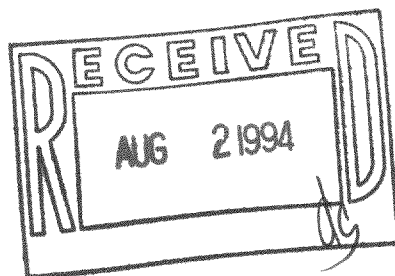

I have surveyed the above-described property,  
and the map hereon is a true representation  
thereof and shows the size and location of the  
property, its exterior boundaries, the location  
and dimensions of all visible structures thereon,  
fences, apparent easements and roadways and  
visible encroachments, if any.

This survey is made for the exclusive use of  
the present owners of the property, and also  
those who purchase, mortgage, or guarantee  
the title thereto, within one year from date  
hereof.

Dated at Burlington, this 18th day,  
of July, 1994  
John F. Degen  
John F. Degen, Land Surveyor S. 242  
689 N. Pine St. Burlington, WI 53105

