


218-77B



IRON STAKES

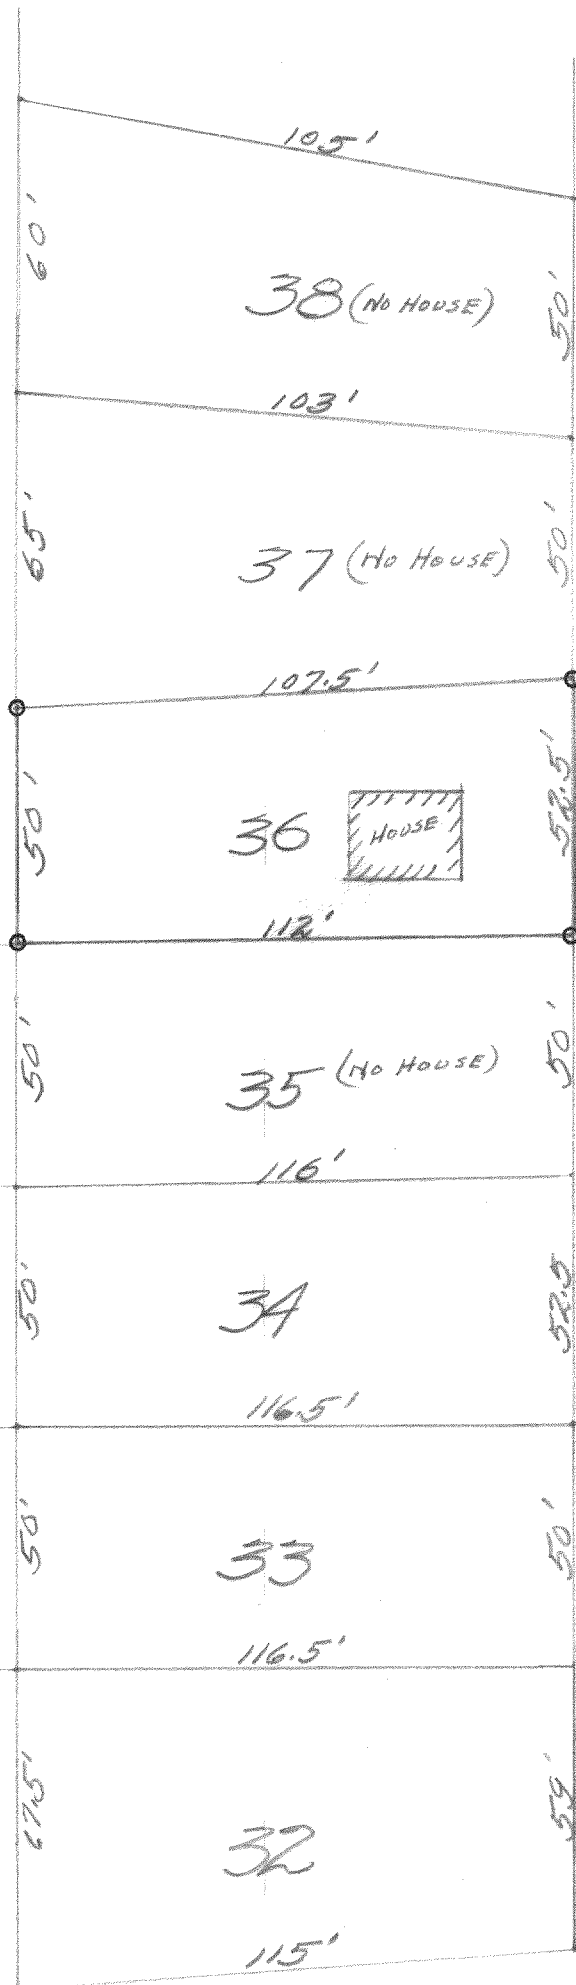

DRIVE

BARRY

DESCRIPTION:

Lot 36 Lake Geneva Golf Hills a subdivision of a portion of Section 31, Township 2 north, Range 18 east of the 4th Principal Meridian.

CERTIFICATE:

I, hereby certify that I have on this the 4th day of August 1949, surveyed the above described property according to the official records on file in the office of the Recorder of Deeds in and for Walworth County, Wisconsin, and find that the measurements and bearings of the boundary lines of said property as taken at the site on this day substantially agree with those in said official record and that no encroachments exist, and that as of this date there is no evidence of a building of any kind on either Lot 37 or Lot 38 as shown.

SIGNED AND SEALED ON THIS THE 5TH DAY OF AUGUST 1949.

Joseph M. Biagi
Joseph M. Biagi. Professional Engineer.
Elkhorn Wisconsin.