ABERNATHY and ASSOCIATES

Kenneth B. Abernathy Jr.

Wisconsin Registered Land Surveyor S-1594


Rt. 3, Box 273

Elkhorn, Wisconsin 53121 Phone: (414) 723-4260 (office)

(414) 723-4813 (residence)

PLAT OF SURVEY

LOT 10 OF CLEAR VIEW ESTATES SUBDIVISION LOCATED IN SECTION 33, TOWN 2 NORTH, RANGE 18 EAST, TOWN OF LYONS, WALWORTH COUNTY, WISCONSIN.

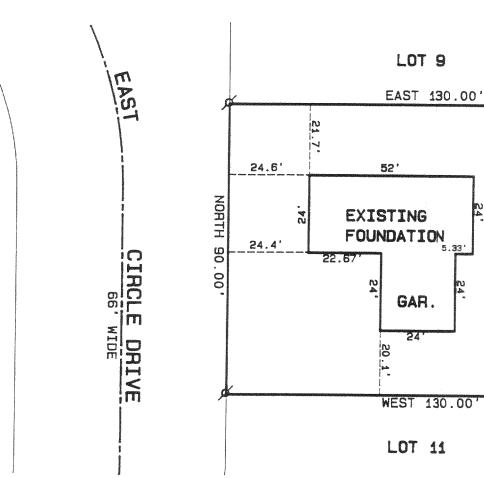

ORDERED BY: SCHAUDER BUILDERS RT. 2 BOX 2BA LAKE GENEVA, WI. 53147 0,

ALITIN

EASEMENT

ABERNATHY, JR.

S-1594

BLOHORN.

NO SURVE

LOT 10

0.26 ACRES

OWNERS: DAVID AND DONNA KRIOFSKY

FOUNDATION "AS-BUILT" LOCATED 7-8-94





SCALE: 1"= 30 FEET

Legend

FOUND IRON PIPE

FOUND IRON ROD

□ FOUND BRASS CAPPED MONUMENT

FOUND CONCRETE MONUMENT

+ CHISEL CUT IN CONCRETE

SET IRON ROD, 24" LONG, WEIGHING 1.5 LBS./LINEAL FT., 3/4" DIA.

SET IRON ROD, 30" LONG, WEIGHING 4.5 LBS./LINEAL FT., 1-11/16" DIA.

(xx) RECORDED AS DIMENSION

EXISTING FENCE

"I hereby certify that I have surveyed the above described property and that the above map is a true representation thereof and shows the size and location of the property, its exterior boundaries, the location of all visible structures and dimensions of all principal buildings thereon, boundary fences, apparent easements, roadways and visible encroachments, if any."

"This survey is made for the use of the present owners of the property, and also those who purchase, mortgage, or guarantee the title thereto within one year from date hereof."

KENNETH B. ABERNATHY, JR. UNISCONSIN REGISTERED LAND SURVEYOR.

S-1594

ate: 6/14/94

6 14 94 Job N REVISED 7/11/94 AS BUILT

AS BUILT" 94.611

NCL- 10