

KOLB LAND CONSULTING, INC.
LAND SURVEYING • SUBDIVIDING • LAND PLANNING

929 WILLIAMS STREET

LAKE GENEVA, WISCONSIN 53147

414 240 3697


ORDERED BY: HOPE MILLER

6597 DEERPATH RD.

LAKE GENEVA, WI. 53147

DEERPATH ROAD 66' WIDE



10' WIDE UTILITY EASEMENT

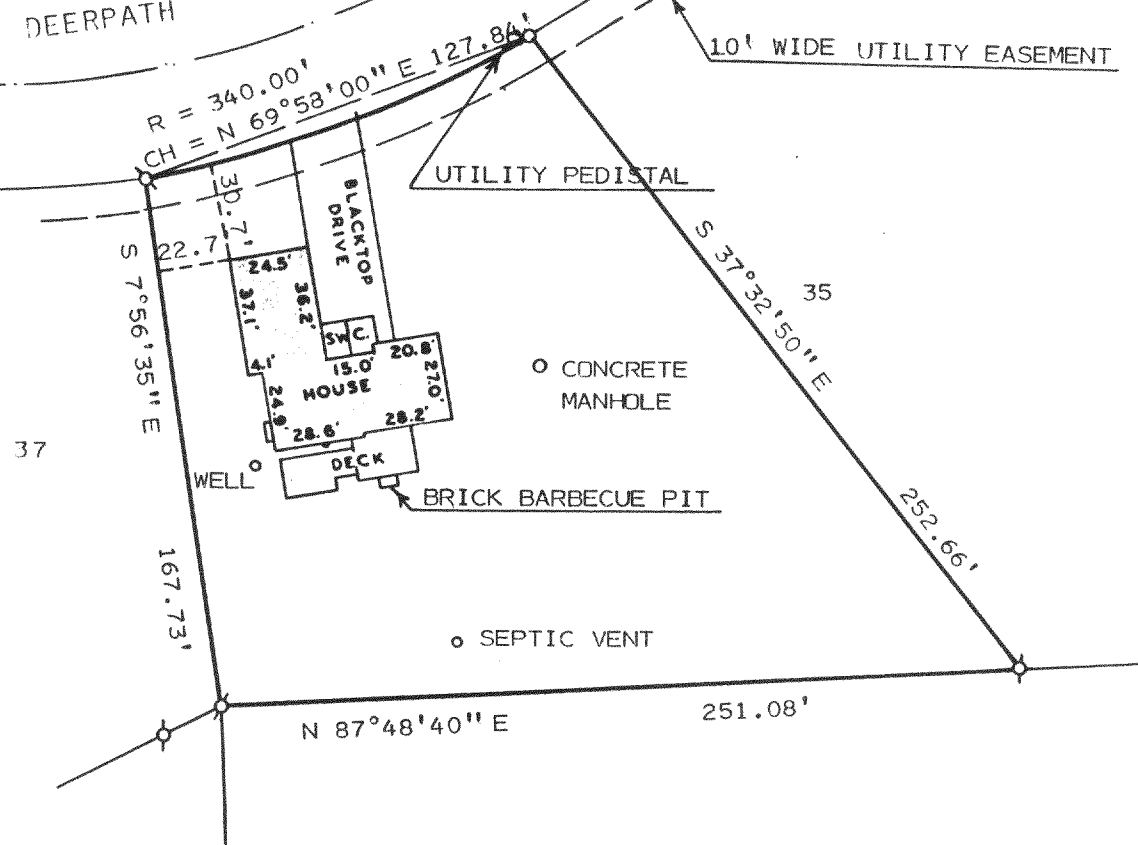

PLAT OF SURVEY OF

NOTE: BEARINGS ARE ASSUMED AS SHOWN ON RECORDED SUB-DIVISION PLAT.

LOT 36 OF GENEVA TERRITORY 1ST ADDITION, A SUBDIVISION LOCATED IN T2N, R18E, TOWN OF LYONS, WALWORTH COUNTY, WISCONSIN.

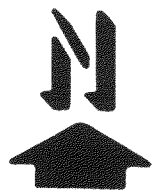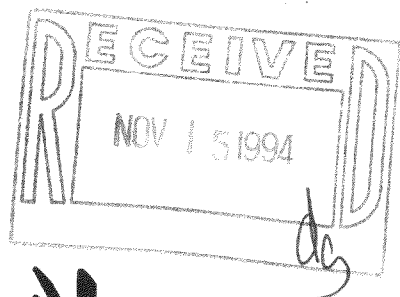

SCALE: 1" = 60'

LEGEND

Ø - IRON PIPE FOUND
O - IRON PIPE SET
SW- SIDEWALK
C.- CONCRETE

I HEREBY CERTIFY THAT I HAVE SURVEYED THE ABOVE DESCRIBED PROPERTY AND THAT THE ABOVE MAP IS A TRUE REPRESENTATION THEREOF AND SHOWS THE SIZE AND LOCATION OF THE PROPERTY, ITS EXTERIOR BOUNDARIES, THE LOCATION OF ALL VISIBLE STRUCTURES AND DIMENSIONS OF ALL PRINCIPAL BUILDINGS THEREON, BOUNDARY FENCES, APPARENT EASEMENTS, ROADWAYS AND VISIBLE ENCROACHMENTS, IF ANY, TO THE BEST OF MY KNOWLEDGE AND BELIEF.

THIS SURVEY IS MADE FOR THE USE OF THE PRESENT OWNERS OF THE PROPERTY AND ALSO THOSE WHO PURCHASE, MORTGAGE OR GUARANTEE THE TITLE THERETO WITHIN ONE (1) YEAR FROM DATE HEREOF.

SURVEY NOT VALID UNLESS SURVEYOR'S SIGNATURE IS IN RED.

HAROLD H. KOLB

WISCONSIN REGISTERED LAND SURVEYOR, S-187

DATE NOVEMBER 23, 1993

REVISED

REVISED

2-18-HDA-36

NDA1-25

218-8105