
N6054 HARGRAVES ROAD BURLINGTON WI. 53105 763-2472

PLAT OF SURVEY OF

LOT 6, BLOCK 3, FIRST ADDITION TO KNOLL BROOK, A SUBDIVISION LOCATED IN THE NORTHWEST $\frac{1}{4}$ OF THE SOUTHWEST $\frac{1}{4}$ AND PART OF THE SOUTHWEST $\frac{1}{4}$ OF THE SOUTHWEST $\frac{1}{4}$ OF SECTION 10, TOWN 2 NORTH, RANGE 18 EAST, TOWN OF LYONS, WALWORTH COUNTY, WISCONSIN.

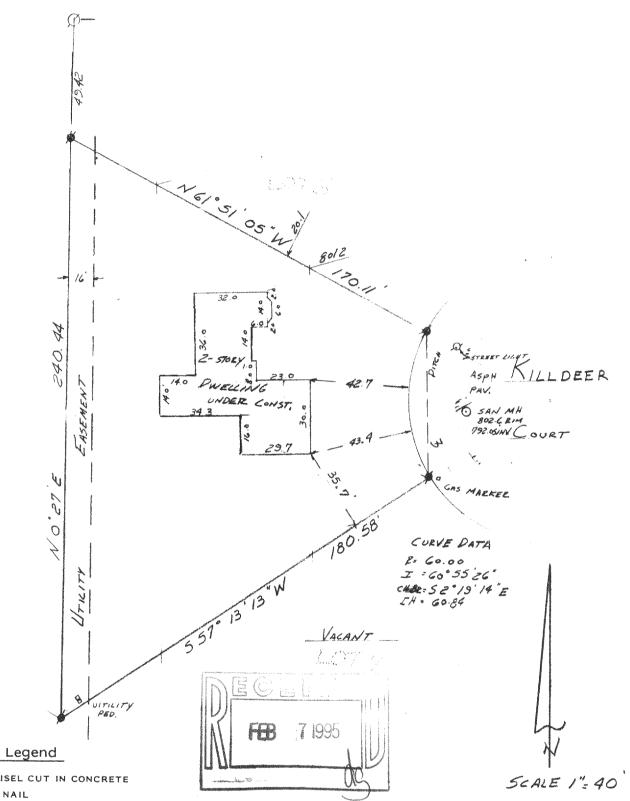

CHISEL CUT IN CONCRETE

- PK NAIL
- FOUND IRON PIPE
- FOUND IRON PIPE
- FOUND BRASS CAPPED MONUMENT
- FOUND CONCRETE MONUMENT

FENCE RECORDED AS *41577.2 S 1500 on Monin

"I hereby certify that I have surveyed the above described property and that the above map is a true representation thereof and shows the size and location of the property, its exterior boundaries, the location of all visible structures and dimensions of all principal buildings thereon, boundary fences, apparent easements, roadways and visible encroachments, if any."

"This survey is made for the use of the present owners of the property, and also those who purchase, mortgage, or guarantee the title thereto within one year from date hereof."

DEAN R.HINTZ

WISCONSIN REGISTERED LAND SURVEYOR,

S-1886

8-20-94

REVISED 10-15-14