
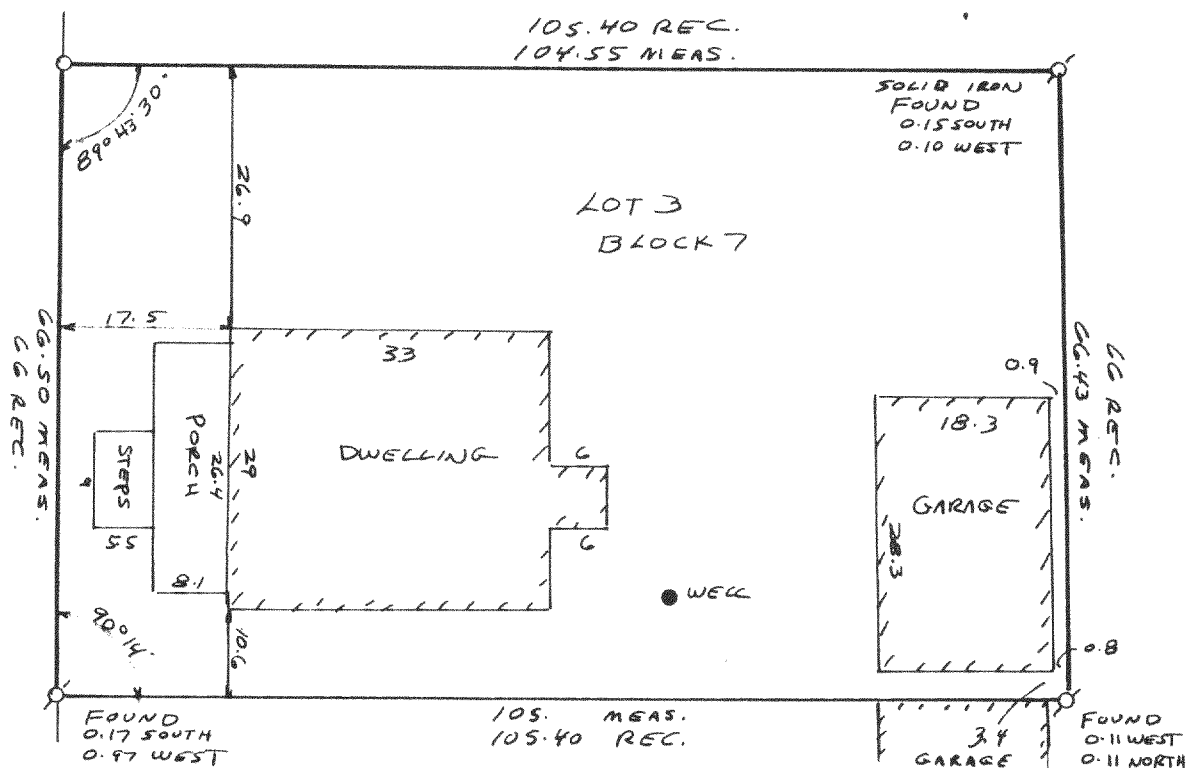


LOT 3, BLOCK 7, BURKE AND CAMPBELL'S VILLAGE OF LYONS, LOCATED IN THE TOWNSHIP OF LYONS  
WALWORTH COUNTY, WISCONSIN.

Ø = IRON PIPE FOUND.

John F. Degen, Land Surveyor S 242  
589 N. Pine St. Burlington, WI 53105

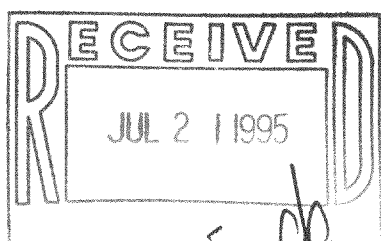

71L-48

218-853

16-C-5 #31