


○ — IRON PIPE FOUND
● — IRON PIPE SET

SCALE 1" = 20 FEET

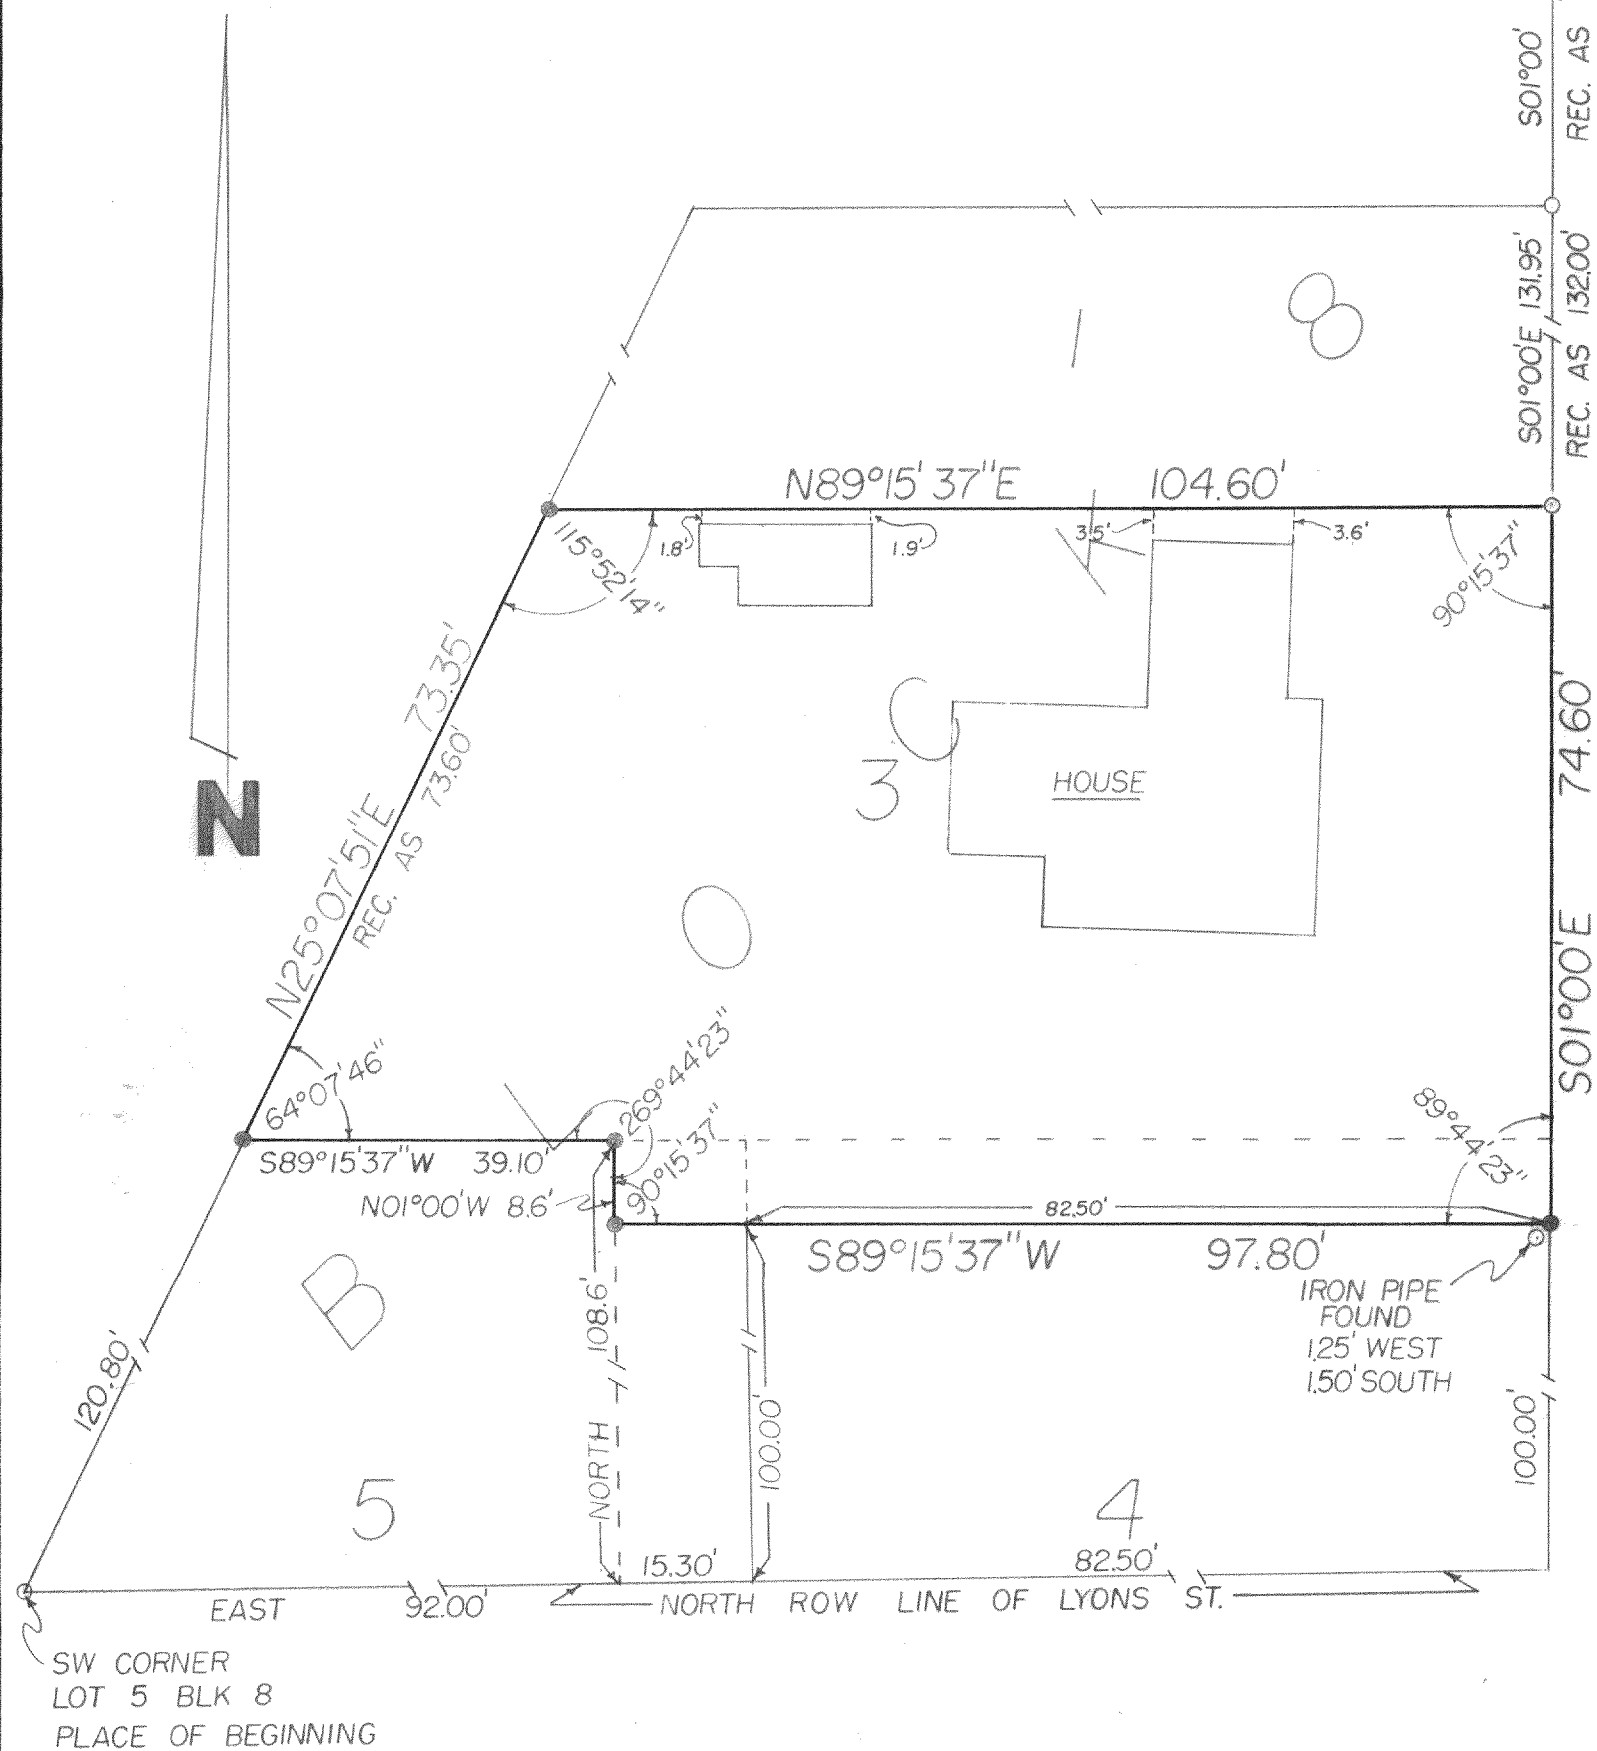


LOTS 3, 4, 8 & 5 OF BLOCK 8 IN BURK & CAMPBELL'S SUBD,
VILLAGE OF LYONS, EXCEPTING THEREFROM THE FOLLOWING
DESCRIBED PARCEL: BEGIN AT THE SOUTHWEST CORNER OF
LOT 5, BLOCK 8 PLAT KNOWN AS BURK & CAMPBELL'S,
VILLAGE OF LYONS, RECORDED IN VOL. 3 OF PLATS, PAGE 3,
LOCATED IN SEC. 10, T.2N R.19E, WALWORTH COUNTY,
THENCE EAST 92.00'; THENCE NORTH 108.6'; THENCE WEST
39.1'; THENCE SOUTHWESTERLY 120.8' TO THE PLACE OF
BEGINNING: ALSO EXCEPTING THEREFROM THE FOLLOWING
DESCRIBED PARCEL OF REAL ESTATE; THE SOUTH 100.00'
OF LOT 4 AND THE EAST 15.30' OF LOT 5, EXCEPTING
THE NORTH 8.60' OF LOT 5, ALL IN BLOCK 8 OF
BURK & CAMPBELL'S VILLAGE OF LYONS, ACCORDING TO
THE RECORDED PLAT THEREOF.

I, JOSEPH M. BIAGI, SURVEYOR, DO HEREBY
CERTIFY THAT I HAVE SURVEYED THE
PROPERTY HEREON DESCRIBED.

SIGNED: OCTOBER 17, 1974

JOSEPH M. BIAGI
203 W. WALWORTH ST.
ELKHORN, WI.

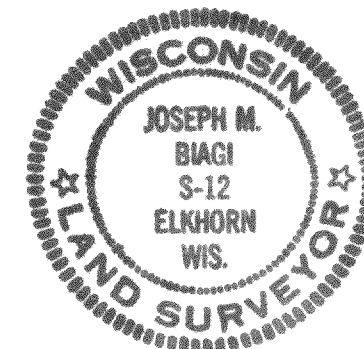

REVISIONS			PLAT OF SURVEY FOR:		
NO.	DATE	BY	MR. SHERMAN E. HARRINGTON		
1			LOT 3 BLK 8 BURK & CAMPBELL SUBD.		
2					
3			DRAWN BY JPR	SCALE 1"=20'	MATERIAL
4			CHK'D	DATE 10-16-74	DRAWING NO. 114-74
5			TRACED	APP'D	

218 - 88 B