
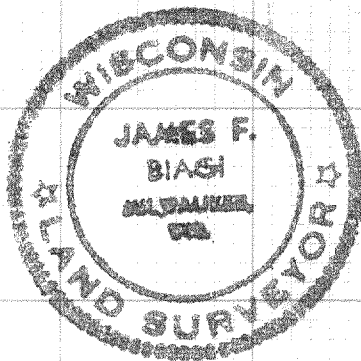


# 41-67

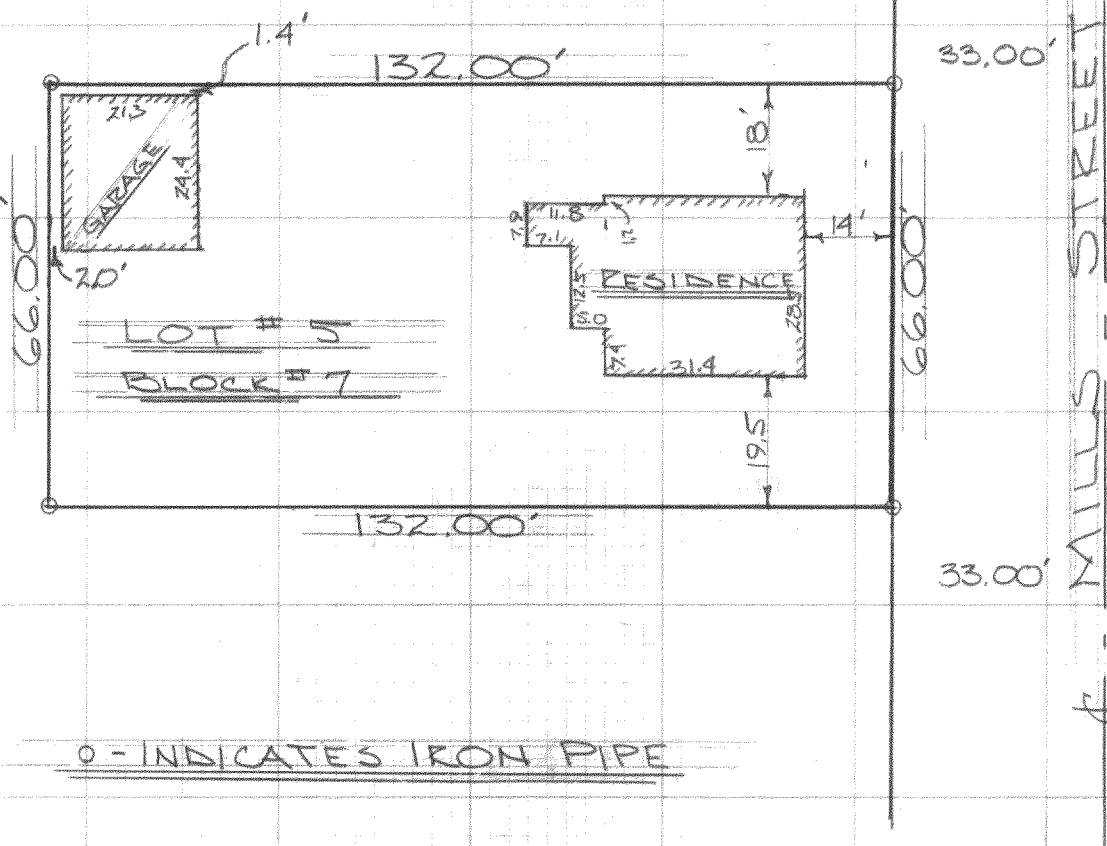

DESCRIPTION: Lot 5, Block 7, Burk and Campbell's Subdivision, being in the Village of Lyons, Walworth County, Wisconsin.

CERTIFICATE: I hereby certify that I have surveyed the above mentioned property and that the hereon portrayed is an accurate survey and a true representation thereof and correctly shows the exterior boundary lines and the location of the buildings and the other improvements thereof.

March 31, 1967

*James F. Biagi*  
James F. Biagi, RLS 272

218-89B