

LAND-MARK SURVEYING

Mark L. Miritz

Wisconsin Registered Land Surveyor S-2582

N9330 Knuteson Drive

Whitewater, WI 53190

Phone: (262) 495-3284

FAX: (262) 495-8421


LAND-MARKSURVEYING.COM

PLAT OF SURVEY

LOT 15, BLOCK 1, OAKWOOD HEIGHTS SUBDIVISION
LOCATED IN THE NE 1/4 OF THE SE 1/4, THE NW 1/4
OF THE SE 1/4 AND THE SW 1/4 OF THE SW 1/4 OF
SECTION 3, TOWN 2 NORTH, RANGE 15 EAST, RICHMOND
TOWNSHIP, WALWORTH COUNTY, WISCONSIN.

ORDERED BY:
DAVID CONROY
51 BRINKER ROAD
BARRINGTON HILLS, IL 60010

OWNER: ARTHUR G. LARSON JR.
P.O. BOX 348
FONTANA, WI. 53125

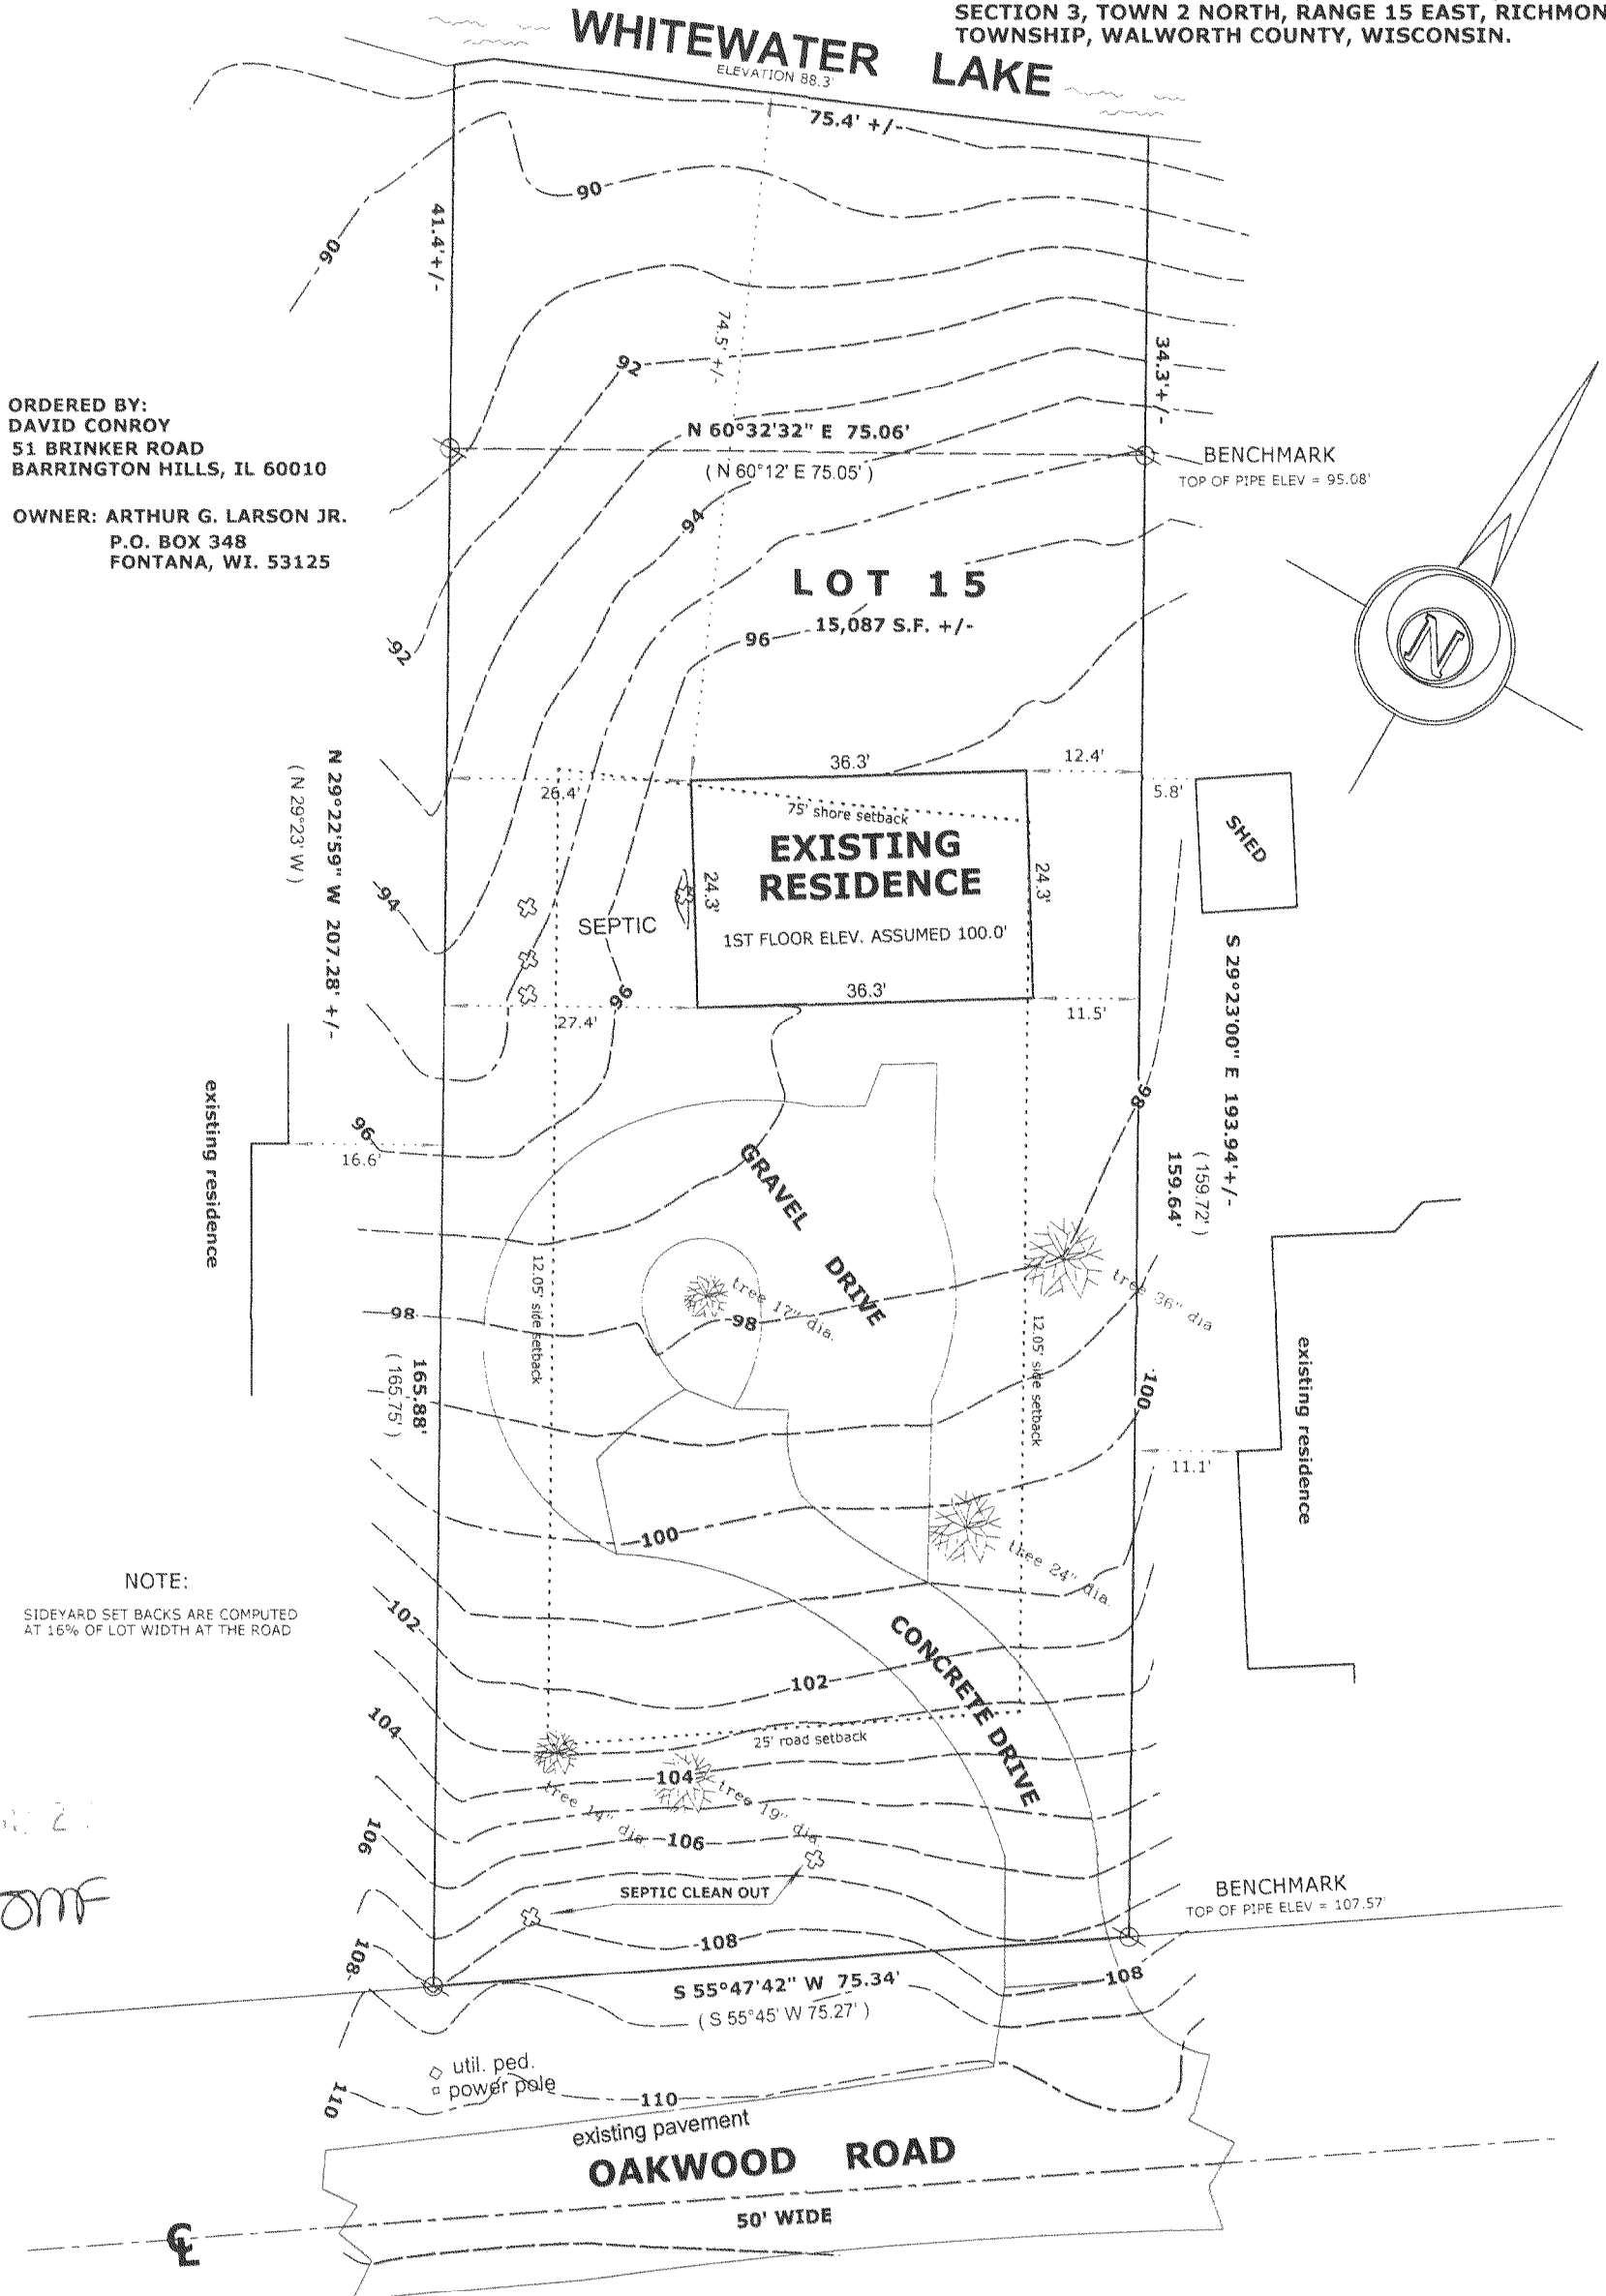

NOTE:

SIDEYARD SET BACKS ARE COMPUTED
AT 16% OF LOT WIDTH AT THE ROAD

LEGEND

- FOUND IRON PIPE
- FOUND IRON ROD
- FOUND COUNTY MONUMENT
- FOUND CONCRETE MONUMENT
- CHISEL CUT IN CONCRETE
- SET IRON ROD, 24" LONG, WEIGHING
1.5 LBS./LINEAL FT., 3/4" DIA.
- RECORDED AS DIMENSION
- EXISTING FENCE



SCALE: 1" = 20 FEET

"I hereby certify that the above described property has
been surveyed by me or under my direction and that the
above map is a true representation thereof and shows the
size and location of the property, its exterior boundaries,
the location of all visible structures and dimensions of all
principal buildings thereon, boundary fences, apparent
easements, roadways and visible encroachments, if any."
"This survey is made for the use of the present owners of
the property, and also those who purchase, mortgage, or
guarantee the title thereto within one year from date
hereof."

Mark L. Miritz
MARK L. MIRITZ
WISCONSIN REGISTERED
LAND SURVEYOR S-2582

DATE: AUG. 11, 2006 JOB NO. 06.802

COWS-10

315-1000