



— WORK ORDERED BY —
SWEET DREAMS CONSTRUCTION
W7965 SWEET ROAD
DARIEN, WI. 53114



FARRIS, HANSEN & ASSOCIATES, INC.
ENGINEERING — ARCHITECTURE — SURVEYING
7 RIDGWAY COURT P.O. BOX 437
ELKHORN, WISCONSIN 53121
OFFICE: (262) 723-2098 FAX: (262) 723-5886

REVISIONS

PROJECT NO.
4078.08
DATE:
04-09-2007
SHEET NO.
1 OF 1

PLAT OF SURVEY

LOT 8 OF HILLSIDE TRAILS, A SUBDIVISION
LOCATED IN PART OF THE NW 1/4 AND NE 1/4 OF THE SW 1/4 OF
SECTION 1, TOWN 3 NORTH, RANGE 15 EAST, WALWORTH COUNTY, WISCONSIN

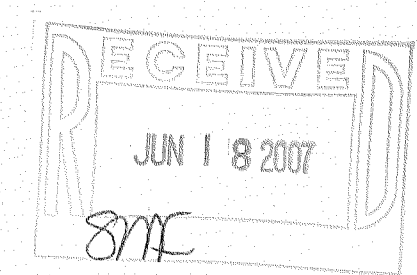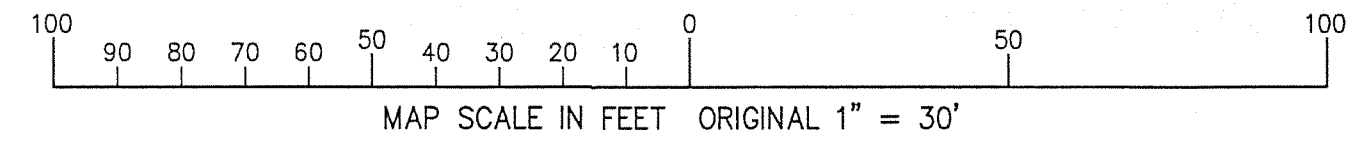


LEGEND
● = FOUND IRON REBAR STAKE
(XXX) = RECORDED AS

NOTE: COPIES OF THIS MAP TO WHICH THE FOLLOWING CERTIFICATE WILL APPLY SHOW THE SURVEYOR'S ORIGINAL SEAL AND SIGNATURE IN RED INK. COPIES BY ANY OTHER MEANS MAY HAVE ALTERATIONS WHICH DO NOT REPRESENT THE SURVEYOR'S WORK PRODUCT.


I HEREBY CERTIFY THAT THE ABOVE DESCRIBED PROPERTY HAS BEEN SURVEYED UNDER MY DIRECTION AND THAT THE ABOVE MAP IS A TRUE REPRESENTATION THEREOF AND SHOWS THE SIZE AND LOCATION OF THE PROPERTY AND ITS EXTERIOR BOUNDARIES. THIS SURVEY IS MADE FOR THE USE OF THE PRESENT OWNERS OF THE PROPERTY, AND ALSO THOSE WHO PURCHASE, MORTGAGE, OR GUARANTEE THE TITLE THERETO WITHIN ONE YEAR FROM THE DATE HEREOF.

DATED: APRIL 10, 2007
REVISED 05-31-2007
TO SHOW SIZE & LOCATION OF
AS BUILT FOUNDATION

Peter S. Gordon
PETER S. GORDON R.L.S. 2101

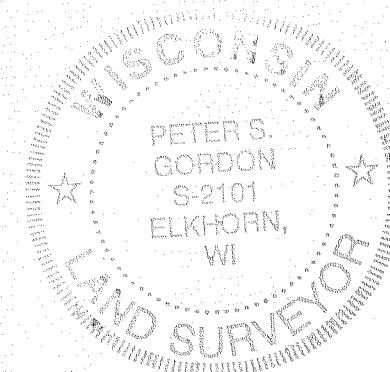

LOT 8
127,465 SQ. FT.

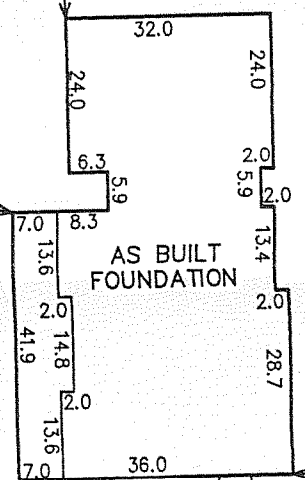

HILLSIDE COURT

ASSIGNED THE N. LINE OF THE SW 1/4
SECTION 1-3-15
N 88°30'40" E

246.17
N 86°59'29" E

50'

R=333.00
78.15
N 03°42'53" E
C=77.97

206.07
N 10°28'17" E

50'

80.9'

R=247.00
63.70
N 03°02'59" E
C=63.52

R=75.00
71.97
N 34°00'24" W
C=74.25

R=75.00
91.93
N 32°25'20" W
C=77.92

S 88°49'50" W
218.25

E. LINE OF THE SW 1/4 OF SECTION 1-3-15 S 01°10'39" E 2639.30'
479.71
S 01°10'39" E

100'

158.4

CHIL-8

315-1023