

PREPARED FOR  
BRIAN SCHUK  
P.O. BOX 524  
DELAVER WI. 53115



# PLAT OF SURVEY

- OF -

LOT 14 OF MEADOWWOOD, A SUBDIVISION  
LOCATED IN THE SOUTHEAST 1/4 OF THE  
NORTHWEST 1/4 AND THE NORTHEAST 1/4 OF  
THE SOUTHWEST 1/4 OF SECTION 12, TOWN 3  
NORTH, RANGE 15 EAST, TOWN OF RICHMOND,  
WALWORTH COUNTY, WISCONSIN.

KROTT SURVEYING INC.

N3705 WILLOW BEND LANE  
LAKE GENEVA WI. 53147  
PHONE # (262)248-3697  
FAX # (262)249-0639

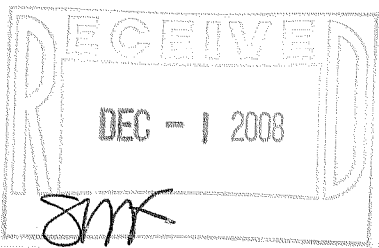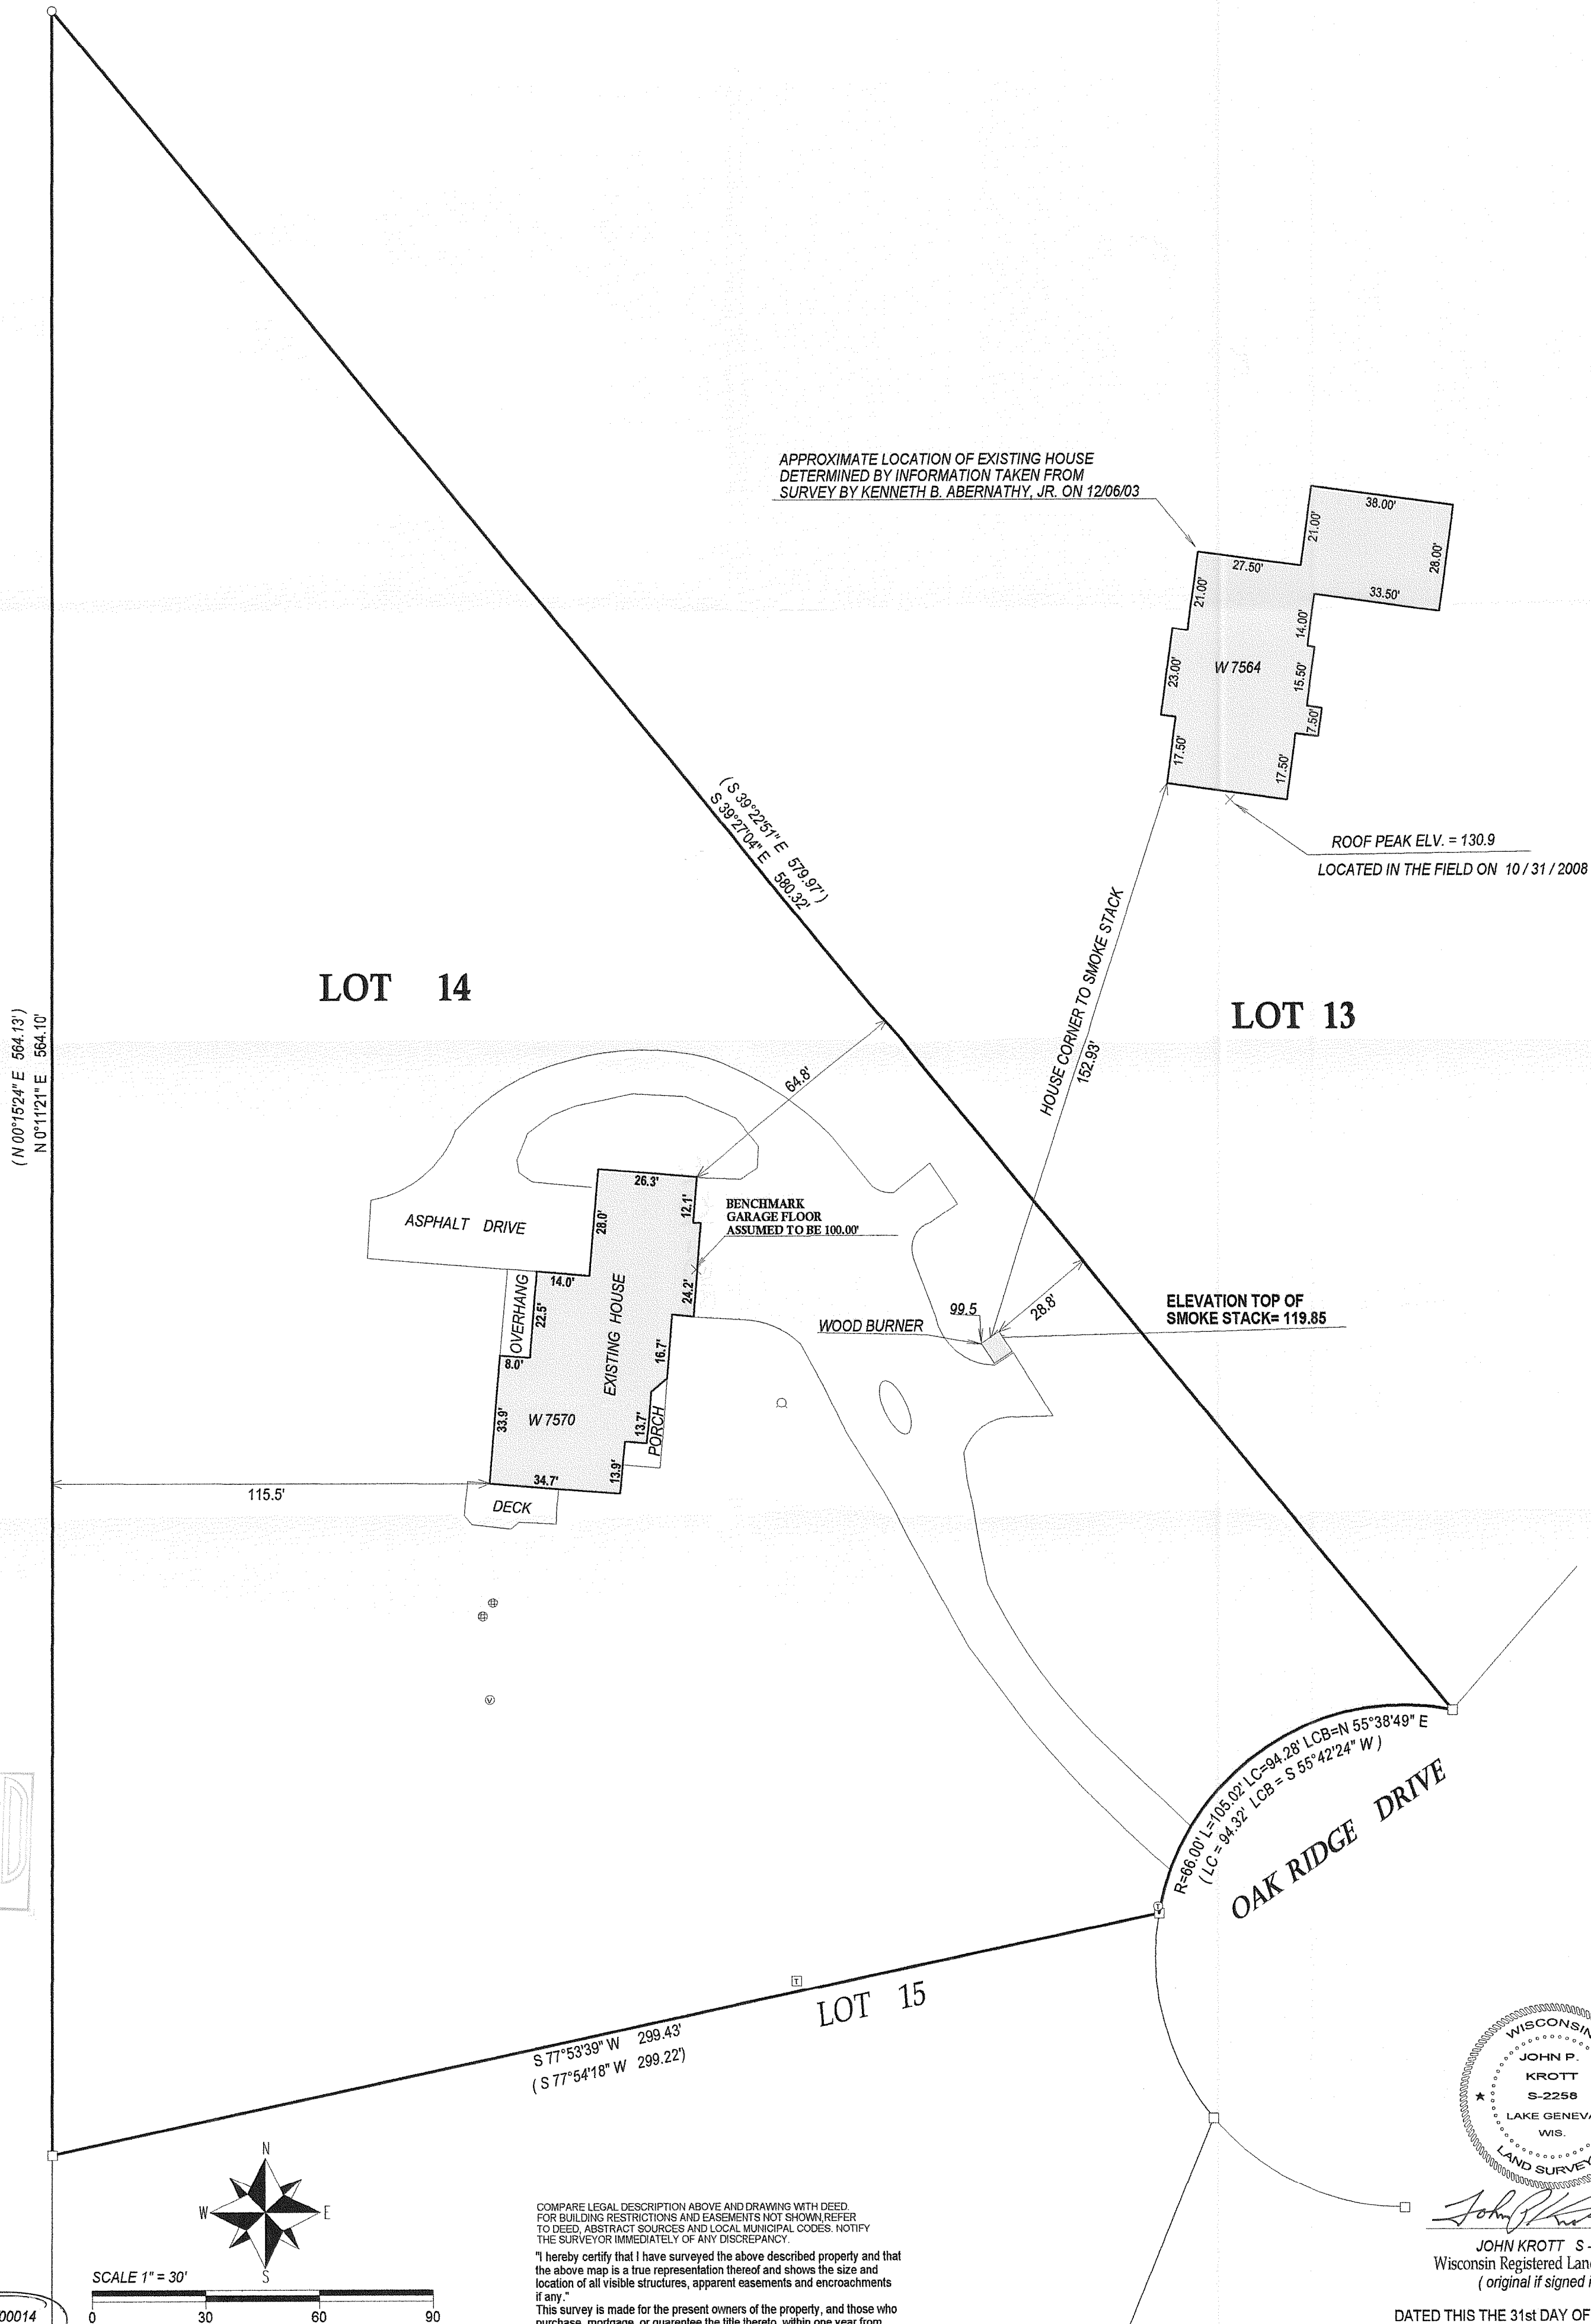

315 - 1075