
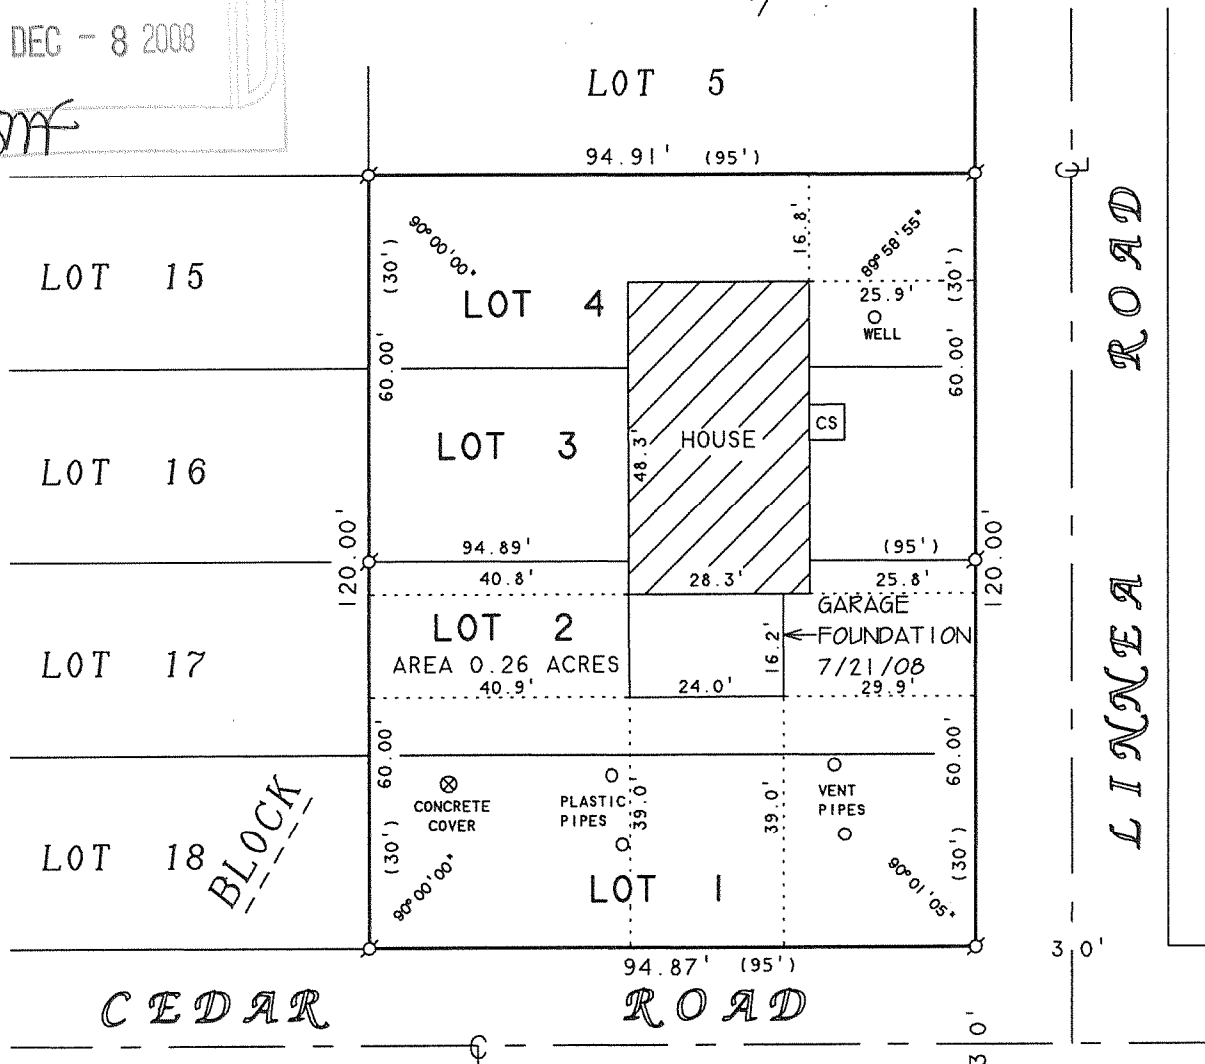


ABELL
SURVEYING & MAPPING

1140 SEQUOIA STREET • DELAVAN, WISCONSIN 53115
262-728-6737

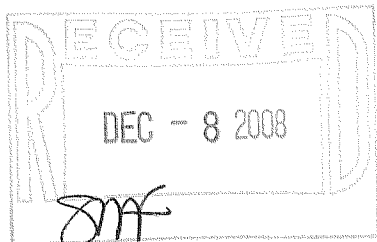

REVISED: JULY 21, 2008 TO SHOW
GARAGE FOUNDATION LOCATION.

REVISED: APRIL 16, 2008 TO SHOW
PROPOSED GARAGE LOCATION.

REVISED: JULY 8, 2002 TO SHOW
HOUSE LOCATION.

REVISED: MAY 13, 2002 TO SHOW NEW
PROPOSED HOUSE LOCATION.

REVISED DATE: MAY 1, 2002
REVISED TO SHOW NEW PROPOSED
HOUSE LOCATION.

ORDERED BY: TAGGART REAL ESTATE
98 E. MAIN STREET
LAKE GENEVA, WI 53147

PLAT OF SURVEY OF

LOTS 1-4, BLOCK 7, SKANSEN SWEDISH TRIBUNE NEWS
SUBDIVISION, LOCATED IN T3N, R15E, WALWORTH
COUNTY, WISCONSIN.

N



SCALE 1"=30'

LEGEND

Ø - IRON PIPE FOUND
CS - CONCRETE STOOP
() - RECORDED AS

I HEREBY CERTIFY THAT I HAVE SURVEYED THE ABOVE DESCRIBED PROPERTY AND THAT THE ABOVE MAP IS A TRUE REPRESENTATION THEREOF AND SHOWS THE SIZE AND LOCATION OF THE PROPERTY, ITS EXTERIOR BOUNDARIES, THE LOCATION OF ALL VISIBLE STRUCTURES AND DIMENSIONS OF ALL PRINCIPAL BUILDINGS THEREON, BOUNDARY FENCES, APPARENT EASEMENTS, ROADWAYS AND VISIBLE ENCROACHMENTS, IF ANY, TO THE BEST OF MY KNOWLEDGE AND BELIEF.

THIS SURVEY IS MADE FOR THE USE OF THE PRESENT OWNERS OF THE PROPERTY, AND ALSO THOSE WHO PURCHASE, MORTGAGE, OR GUARANTEE THE TITLE THERETO WITHIN ONE (1) YEAR FROM DATE HEREON.

David F. Abell

DAVID F. ABELL
WISCONSIN REGISTERED LAND SURVEYOR, S-1596

April 15, 2002

DATE: APRIL 15, 2002
JOB NUMBER - 92020G
NOTE: THIS IS NOT A CERTIFIED COPY UNLESS SEALED.

CS-118

315-1078