


GEORGE T. DUNHAM
SURVEYING & SUBDIVIDING
DELAVER, WISCONSIN

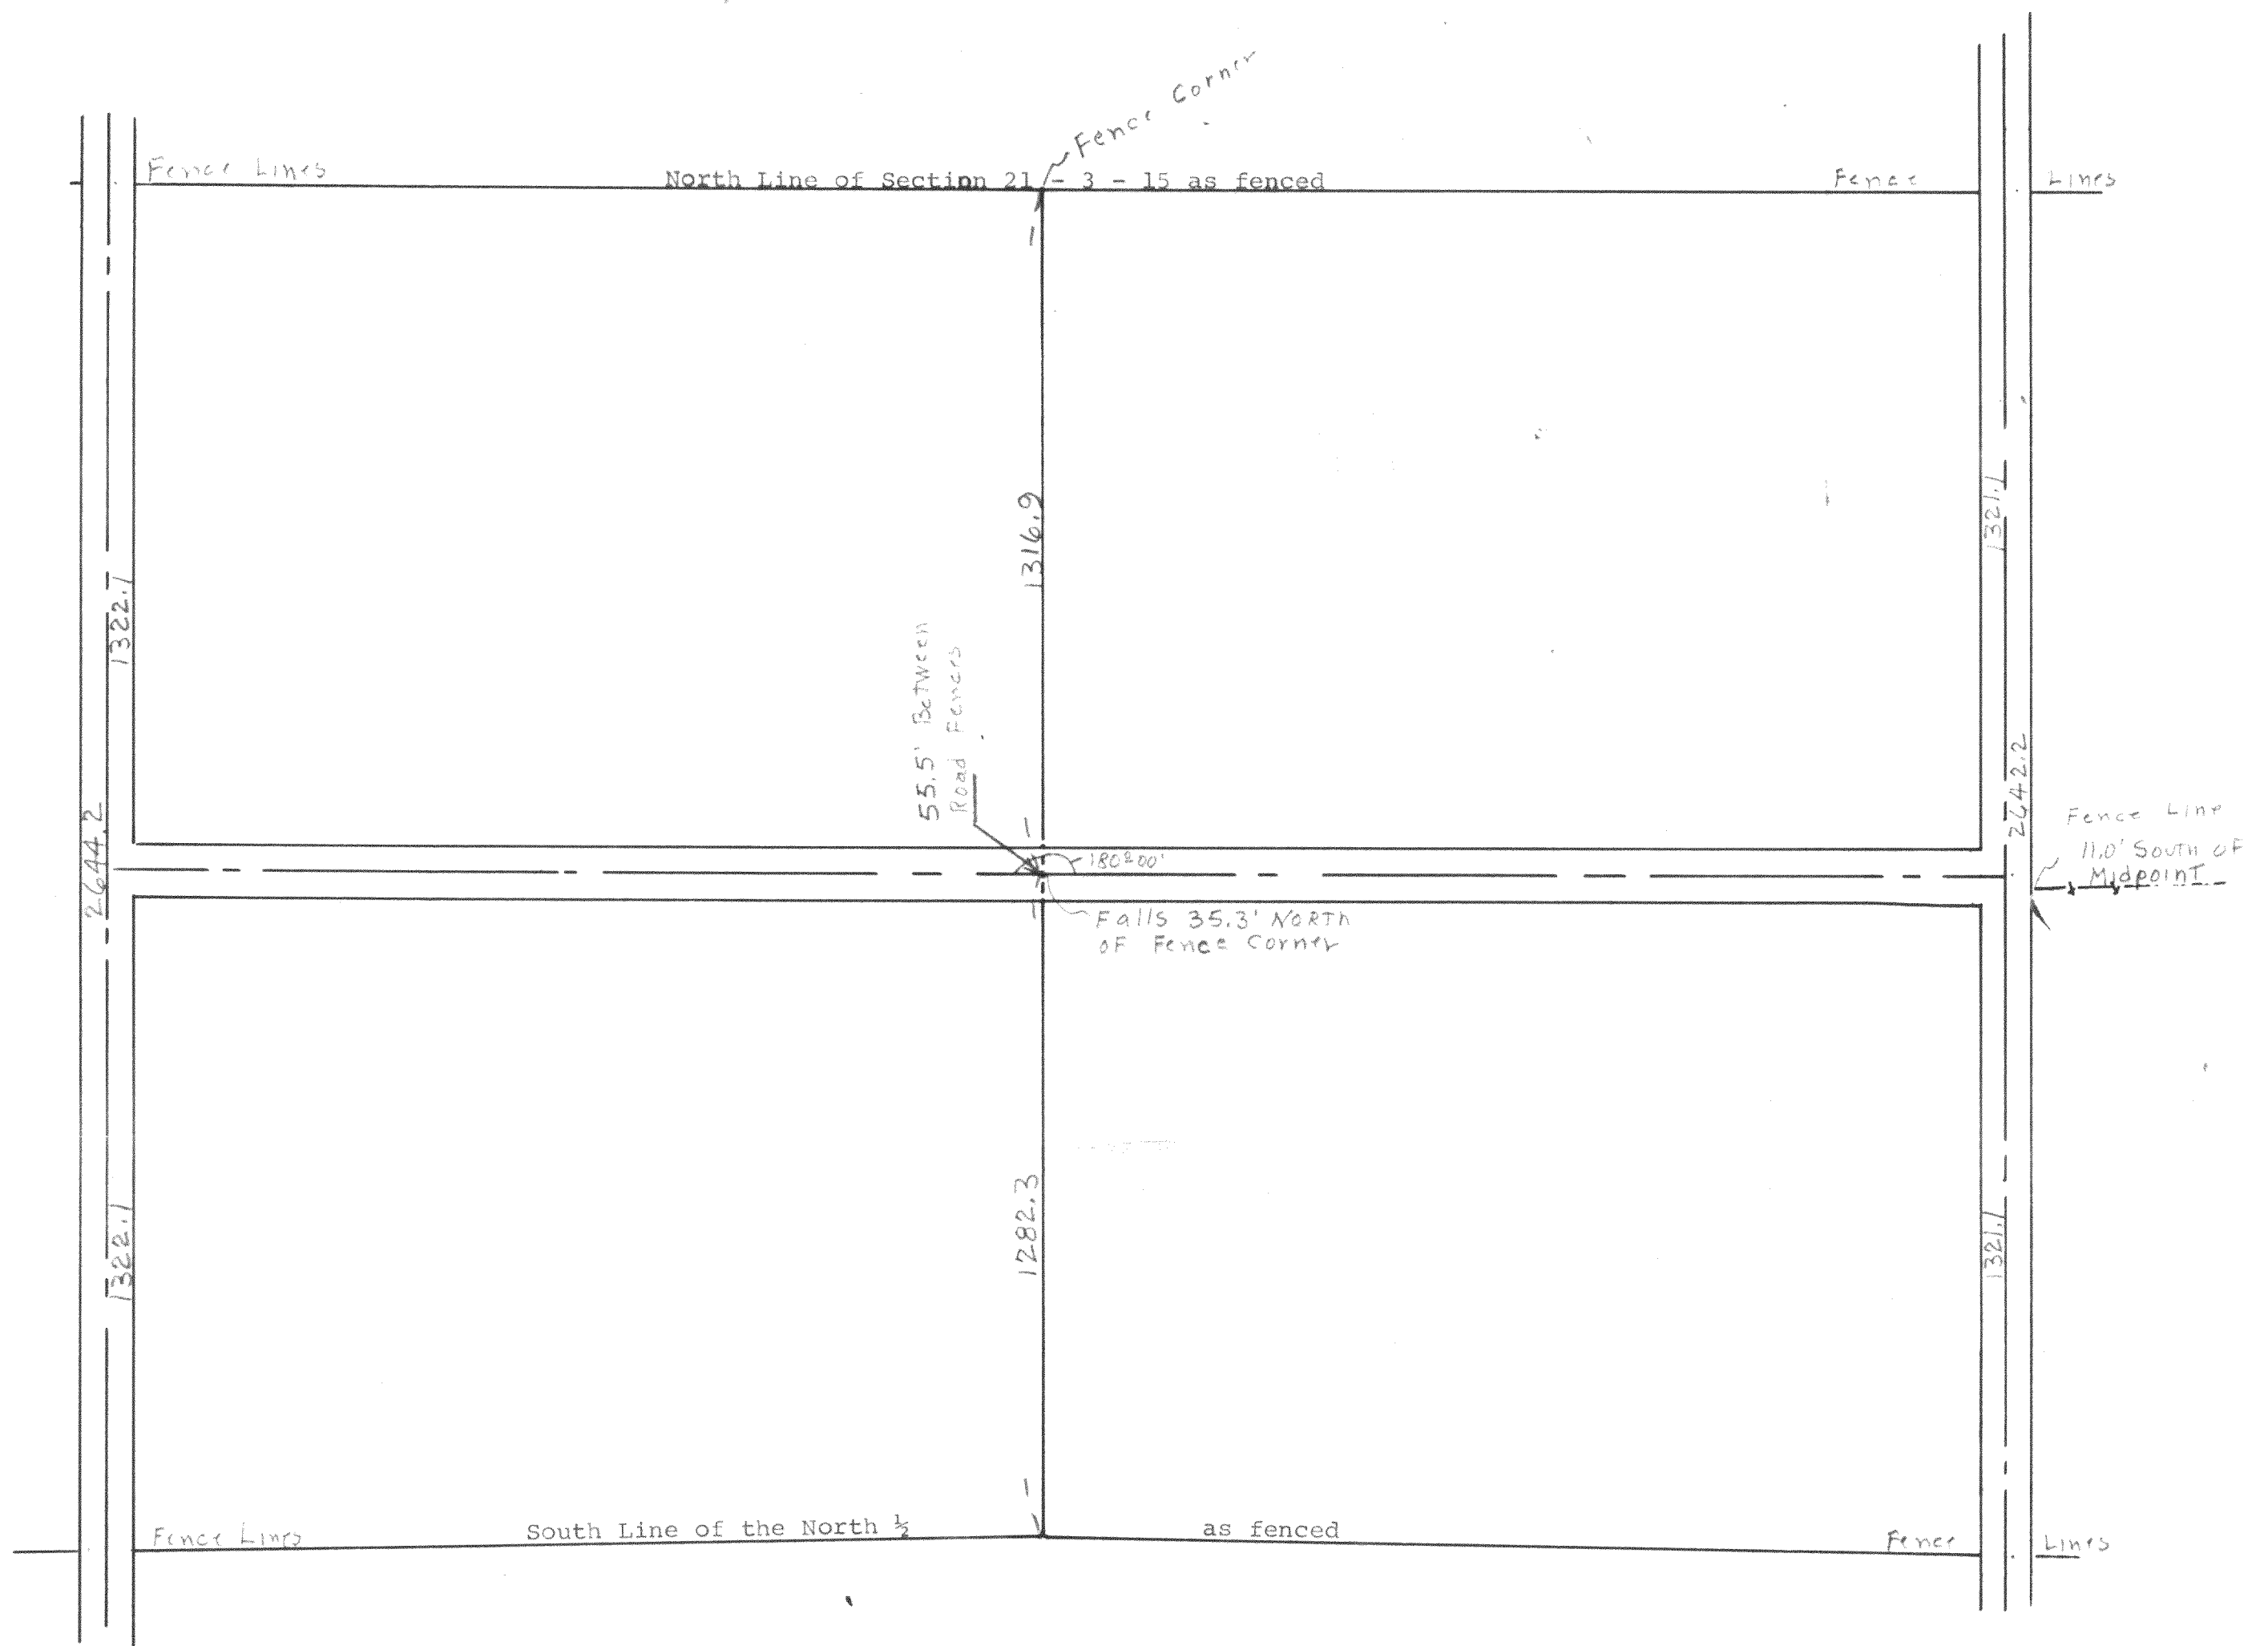

R-21-1
21-2
21-3 + R-21-3B
21-4
21-5

Sketch showing North-South Measurements of the North $\frac{1}{2}$
of Section 21 along and between existing fence lines
T 3 N, R 15 E, Walworth County, Wisconsin.
July 1966

George T. Dunham
George T. Dunham, Surveyor

315-11