PLAT OF SURVEY


PHONE: 262-537-4874

FAX: 262-537-4221

OF

Lots 3, 4, 5, and 6, in Block 24 of SKANSEN SWEDISH TRIBUNE—NEWS SUBDIVISION, in the Southwest Quarter of Section 9, Township 3 North, Range 15 East of the 4th Principal Meridian, Town of Richmond, Walworth County, Wisconsin.

PARCEL IDENTIFICATION NO. Lots 3 & 4: CS 00354 PARCEL IDENTIFICATION NO. Lots 5 & 6: CS 00355

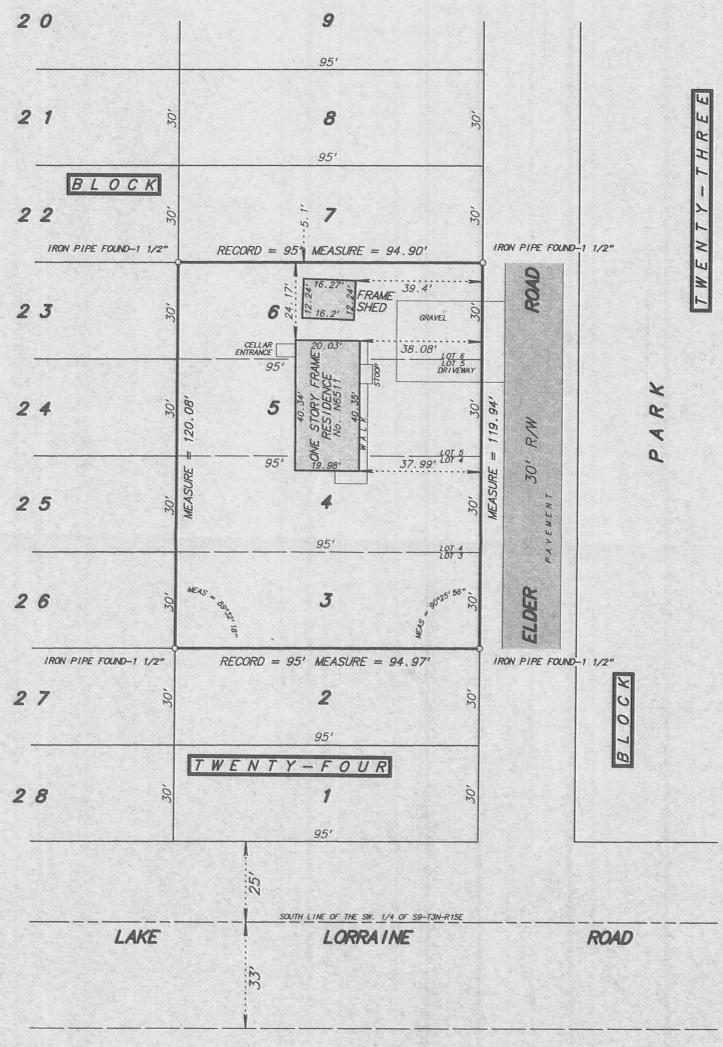

NOTE:
- THIS SURVEY IS A RETRACEMENT OF A SURVEY SIGNED BY ROBERT A. FARRIS, S-1293, OF FARRIS, HANSEN & COOPER, INC., DATED AUGUST 10, 1978.

SCALE:	1 inch = 30 feet	
ORDERED	BY: J. Lehmann	
JOB NO.	07211	

DEGETUED

MAY 05 2010

By

Fieldwork	completed	on an	d date	of	certification:	Sep	tember	14.	2007
								AND WINDS FOR SHIP	PORTS TWANTER TO BE A SEC CO. IN

and also those who purchase, mortgage or guarantee the title thereto within ONLYEAR from the date hereof.

Dated at Bassett, W	isconsin	this	day of _	2	007.
					ERIAL CENT

Mark A. Bolender Wisconsin Registered Land Surveyor S - 1784

315-1116

I hereby certify that I have surveyed the above described property and the above plat is a true representation thereof and shows the size and location of the property, its exterior boundaries, the location and dimensions of all visible structures thereon, boundary fences, apparent easements and roadways and visible encroachments, if any.