

JOHNSON, AVERILL & ASSOC, inc.

LAND PLANNING
SITE DEVELOPMENT ENGINEERING
SURVEYING
DRAINAGE ENGINEERING

CIVIL ENGINEERS — LAND SURVEYORS
420 FREDERICK, WAUKESHA, WISCONSIN
TEL. NO. (414) 544-5808

PAUL A. JOHNSON P.E.
LEWIS A. AVERILL P.E.
WILLIAM E. YACH R.L.S.


PLAT OF SURVEY

PREPARED FOR: Huml - Johnson

DESCRIPTION: Parcel 27

That part of the Northwest 1/4 of Section 2, Town 3 North, Range 15 east, in the Town of Richmond, Walworth County, Wisconsin, bounded and described as follows:

Commencing at the Southeast corner of said 1/4 Section; thence N 0° 45' 16" W, along the East line of said 1/4 Section, 318.88 feet to a point; thence S 89° 14' 44" W, 699.94 feet to a point in the centerline of a proposed road; thence S 0° 45' 16" E, along said centerline, 328.12 feet to a point in the South line of said 1/4 Section; thence N 88° 29' 23" E, along said South line, 700.00 feet to the point of commencement. Containing therein 5.1981 acres of land.

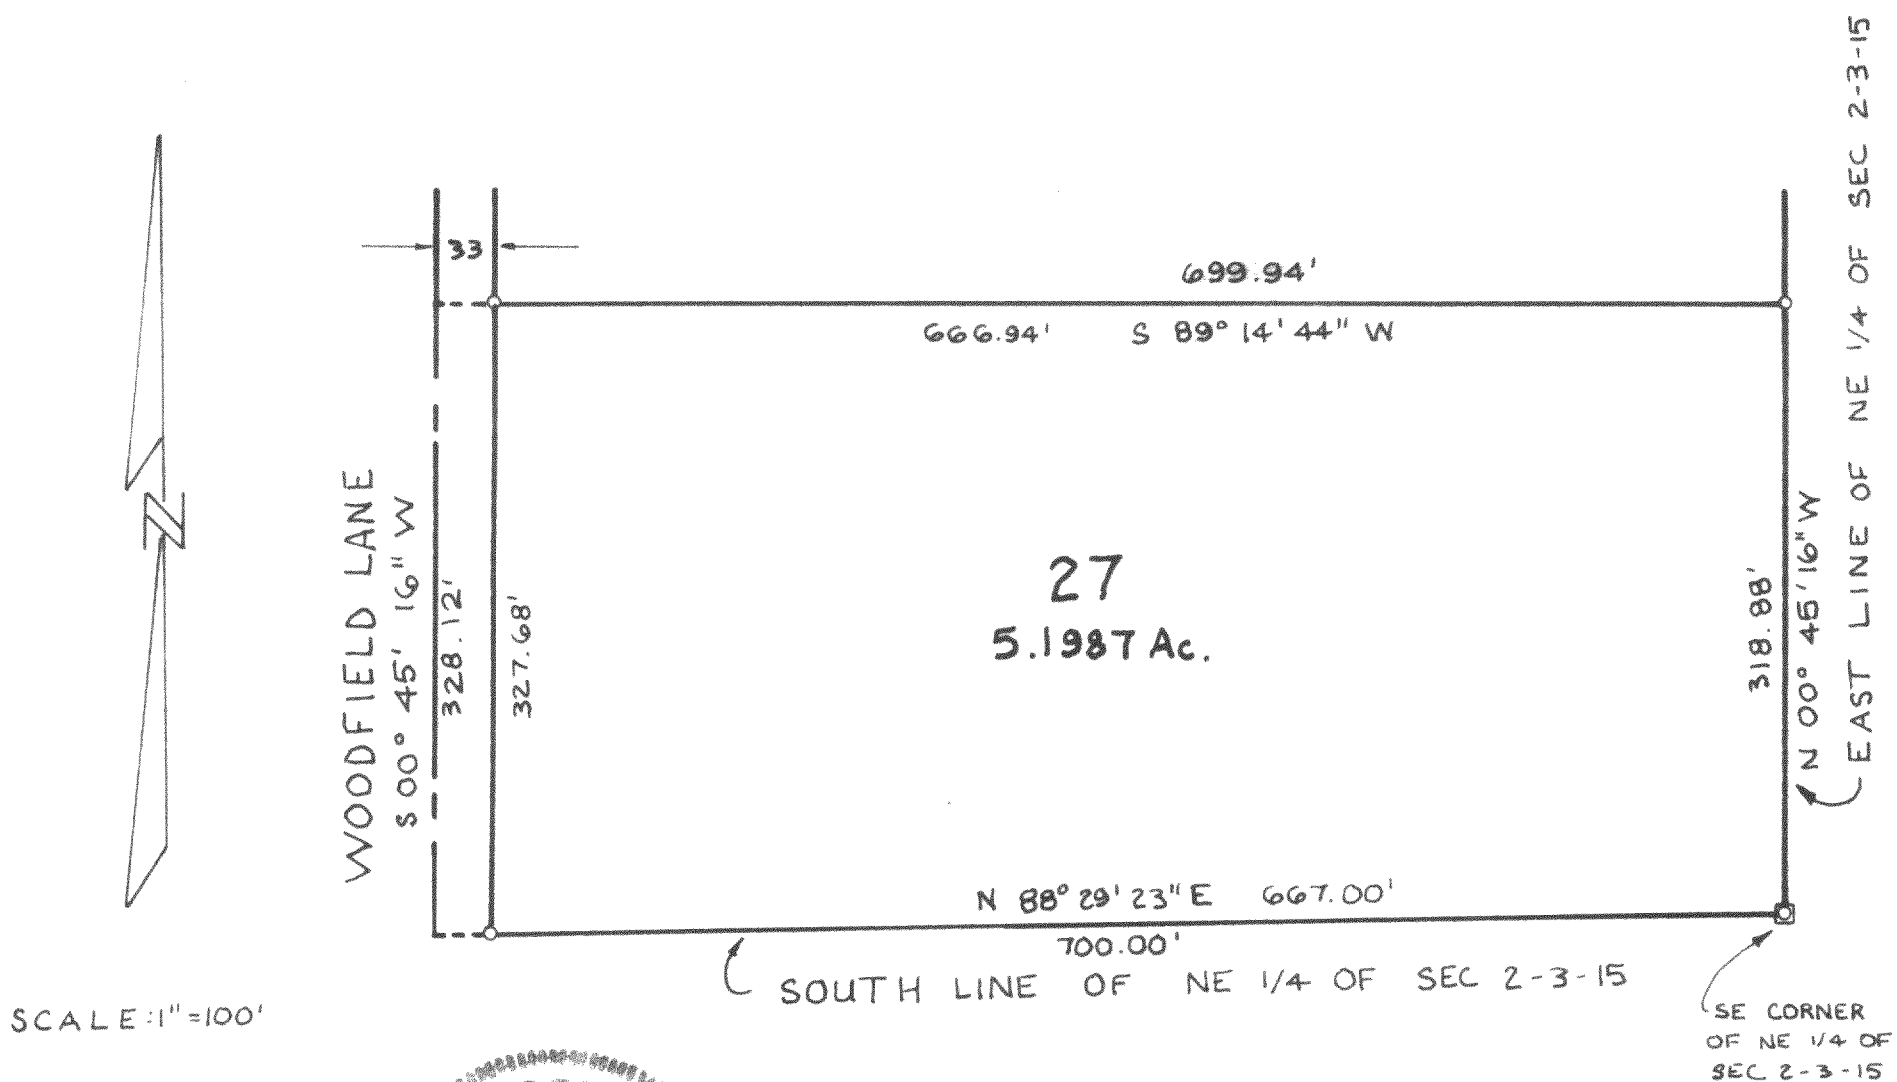

STATE OF WISCONSIN
COUNTY OF WAUKESHA

I hereby certify that I have surveyed the above described property and the above map is a true representation thereof and shows the size and location of the property, its exterior boundaries, the location of all visible structures and dimensions of all principle buildings thereon, boundary fences, apparent easements, roadways and visible encroachments, if any.

This survey is made for the present owners of the property, and also those who purchase, mortgage, or guarantee the title thereto within one (1) year from date thereof.

Dated at WAUKESHA, WISCONSIN this 30th day of JUNE, 19 78 Recertified _____

William E. Yach
WILLIAM E. YACH Registered Land Surveyor

JOB NO.

R-2-35

315-127-K