


KOLB LAND CONSULTING, INC.
LAND SURVEYING • SUBDIVIDING • LAND PLANNING

LAKE GENEVA, WISCONSIN 53147

WHITEWATER, WISCONSIN 53190

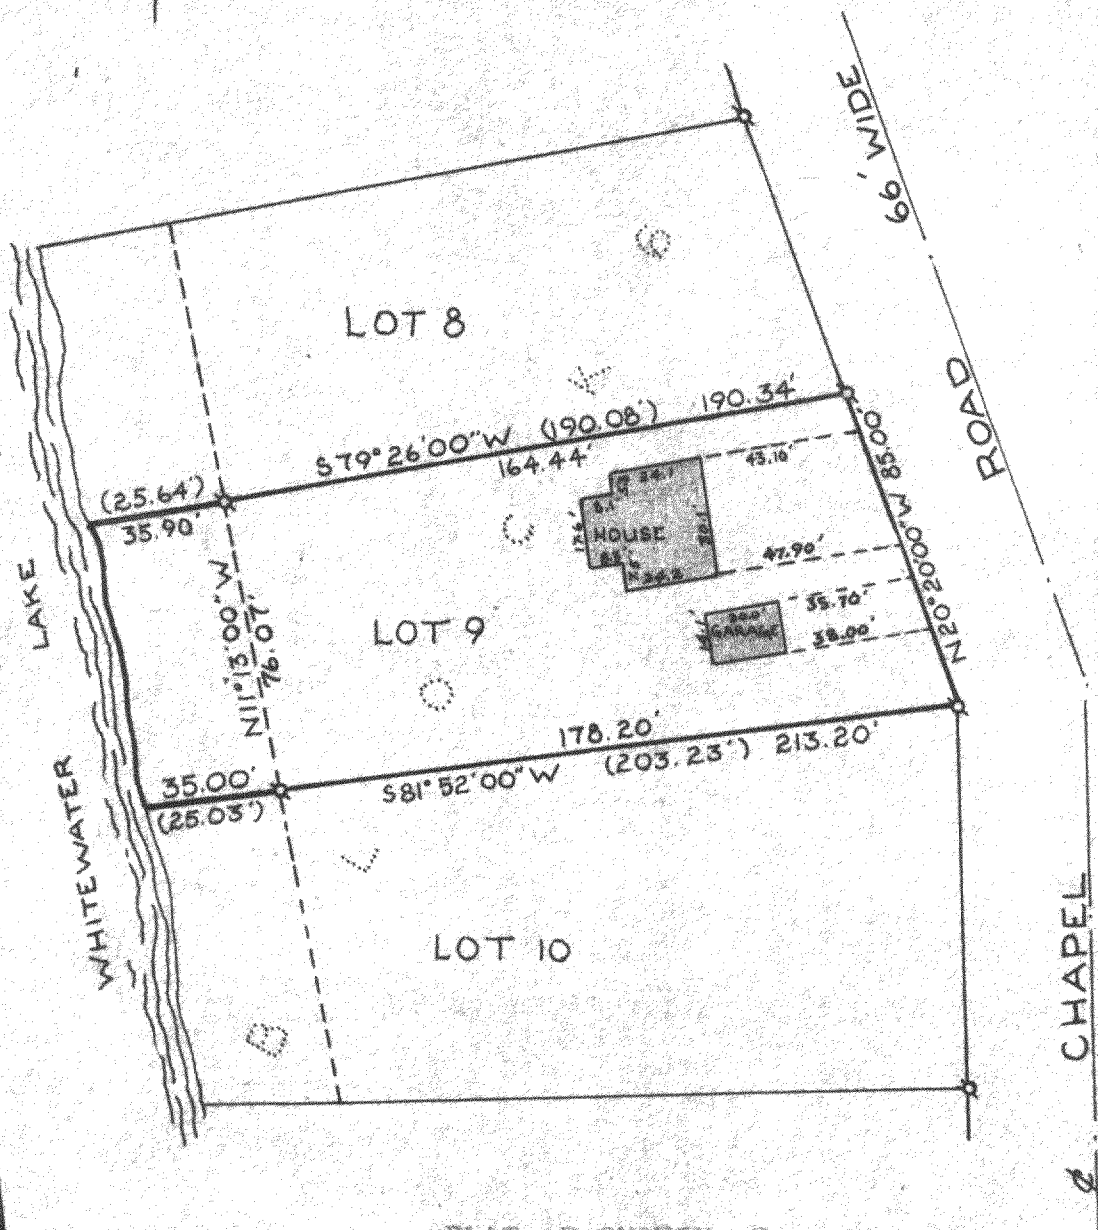

PLAT OF SURVEY OF

Lot 9, Block 6, Chapel Hills Subdivision,
located in the Northeast 1/4 of Section 3,
T3N, R15E, Walworth County, Wisconsin.


Note: Bearings assumed as platted.

Owned by: Albert Patterson
353 Eagle Lane
Bloomington, Ill. 60108

SCALE: 1"=50'

LEGEND

⊙ - IRON PIPE FOUND
() - AS PLATTED

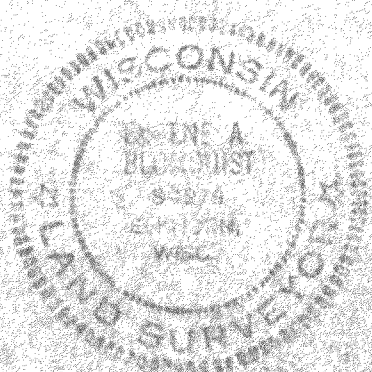

I, Eugene A. Blomquist, do hereby certify
that I have surveyed the property hereon
described according to the official records
and that the plat hereon is a correct
representation of the lot lines.

Eugene A. Blomquist

WISCONSIN REGISTERED LAND SURVEYOR, S-1279

DATE June 1, 1979

CCH-14A

315-139 ✓