
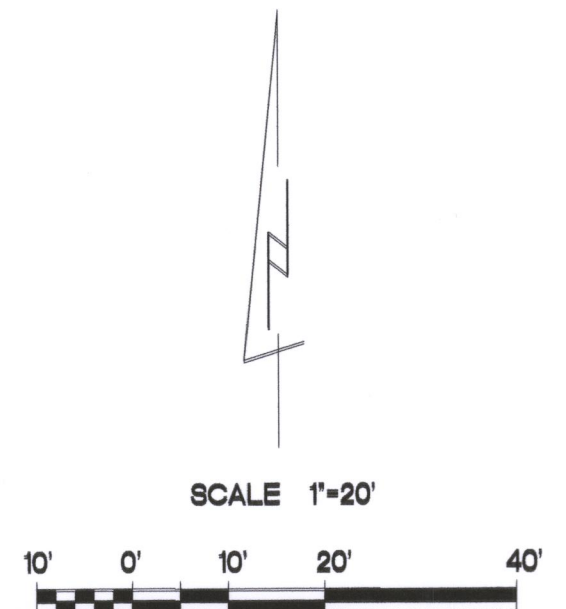


PLAT OF SURVEY


LOTS 8, 9, AND 10, BLOCK 7, SKANSSEN SWEDISH TRIBUNE NEWS SUBDIVISION, BEING A PART OF THE SOUTHWEST 1/4 OF SECTION 9, TOWN 3 NORTH, RANGE 15 EAST, TOWN OF RICHMOND, WALWORTH COUNTY, WISCONSIN.
SURVYED FOR: RANDY DREDLOW

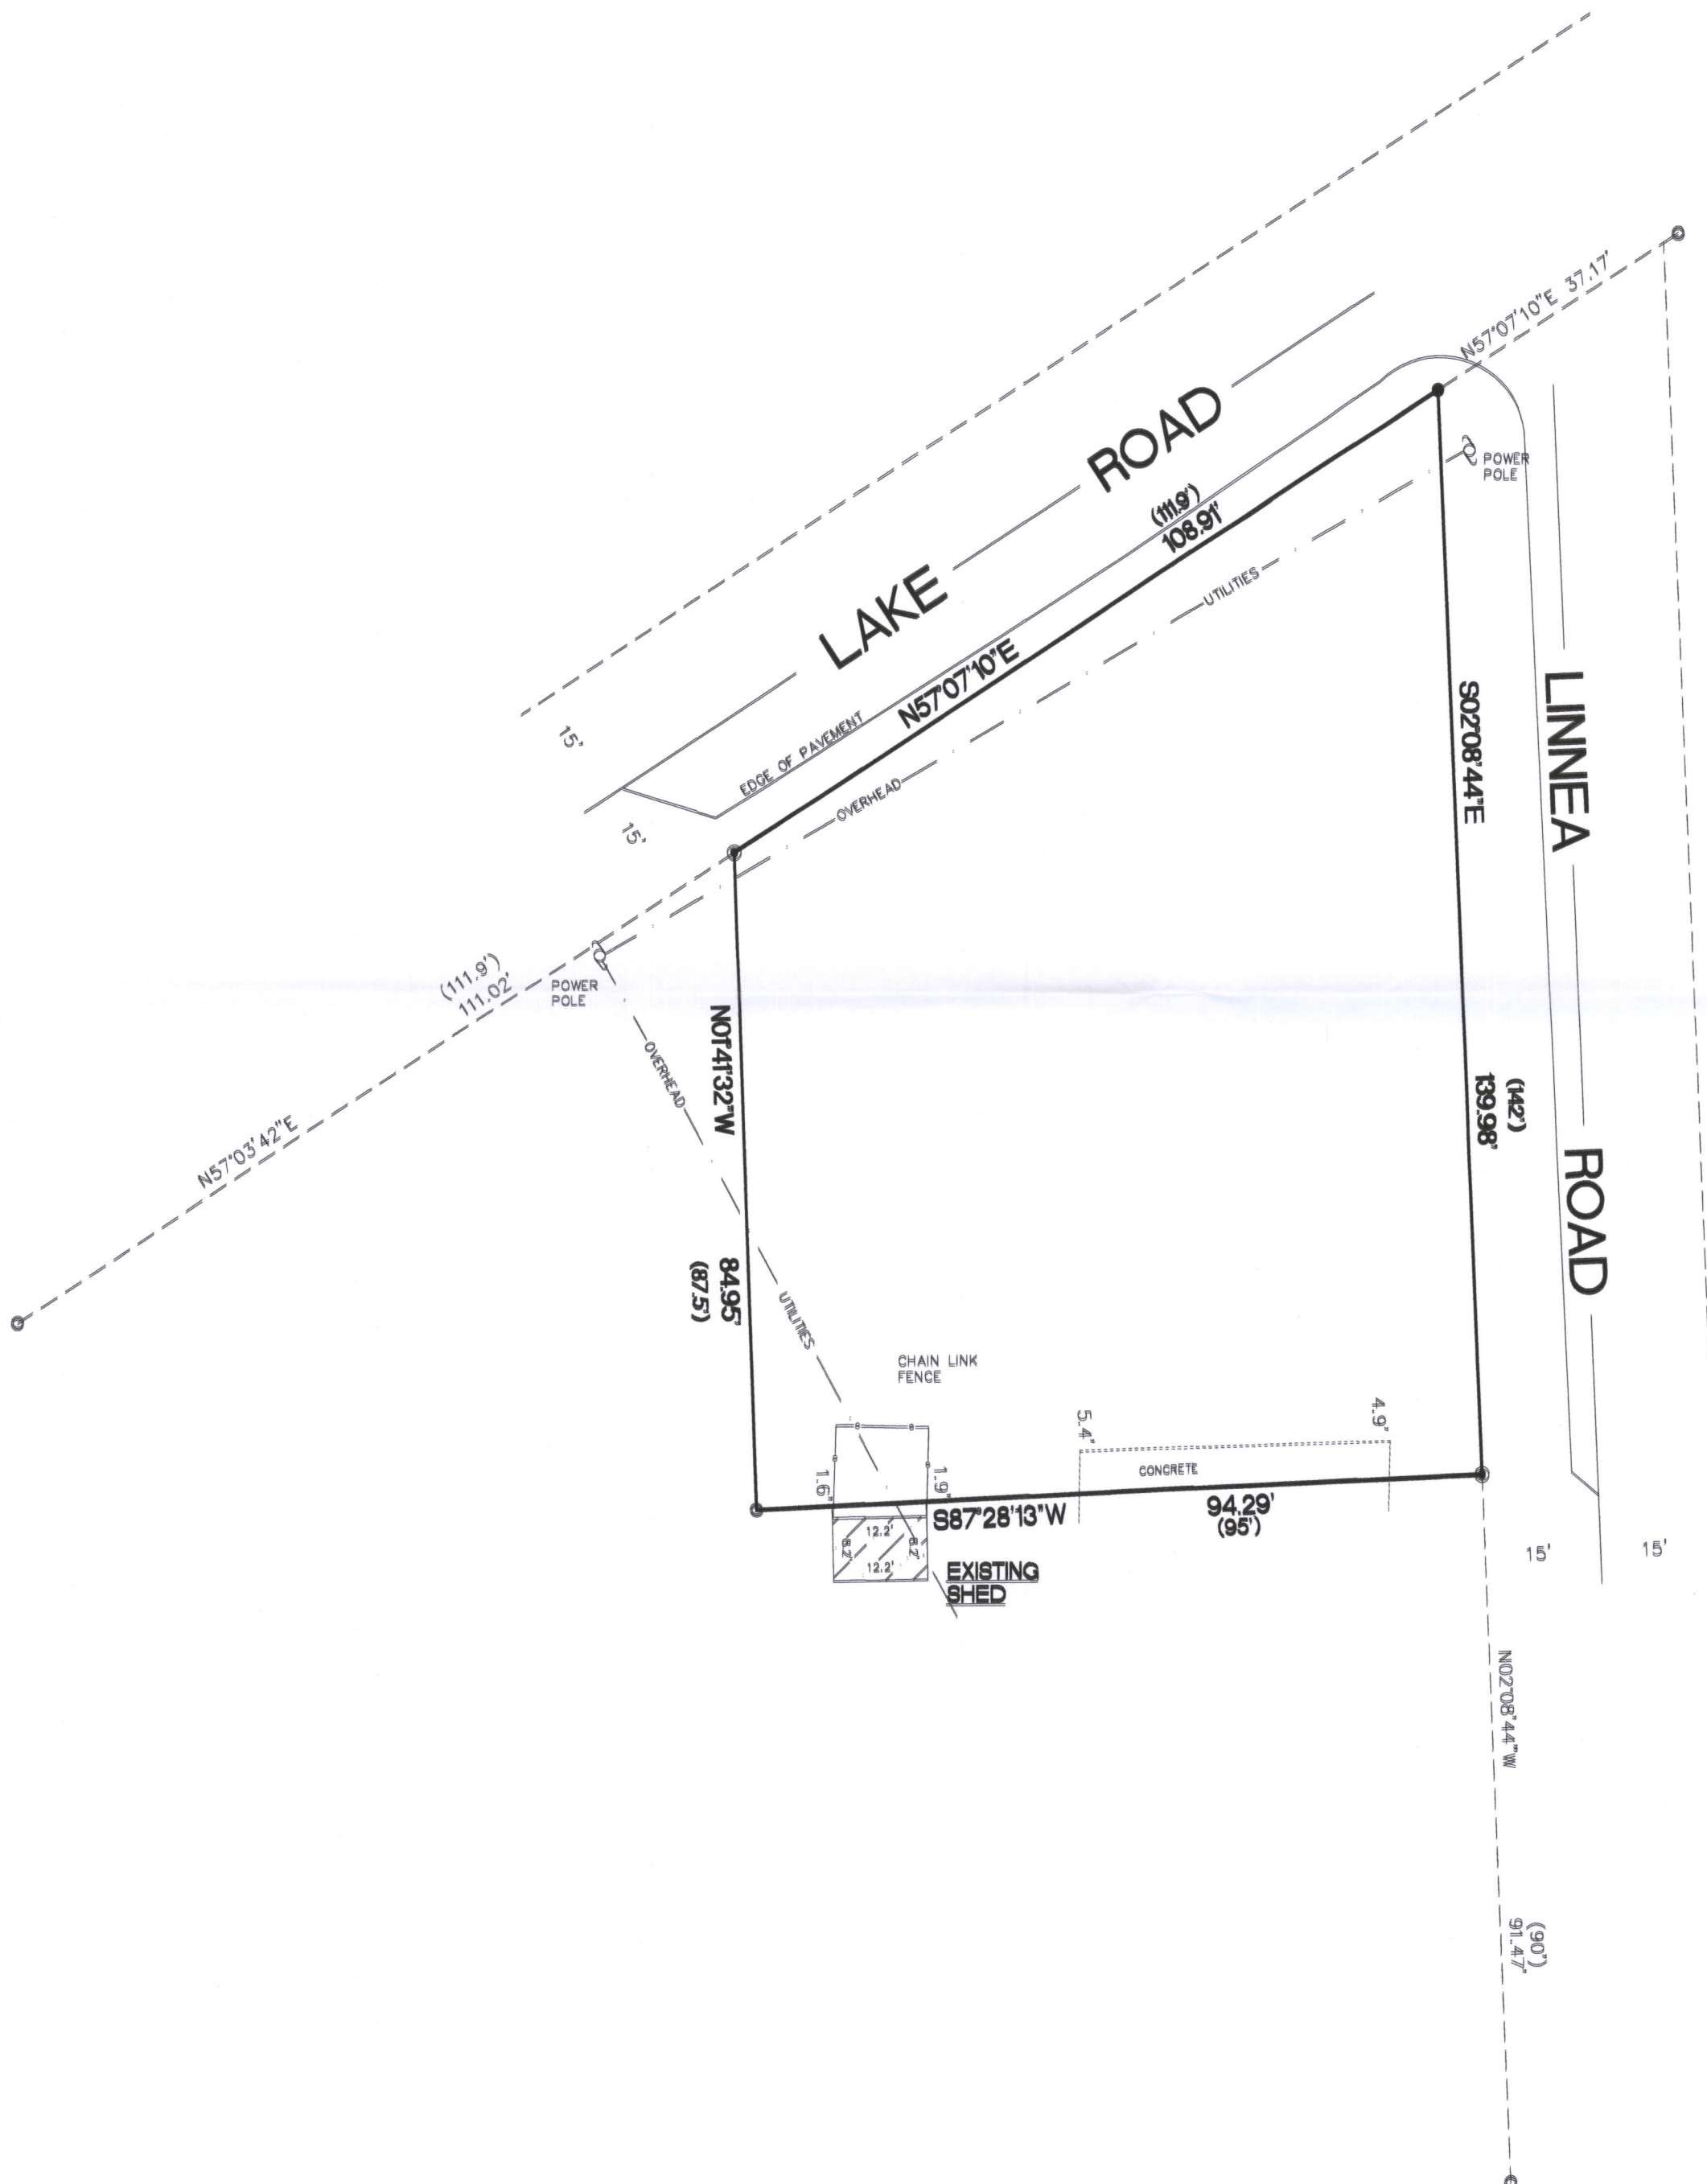

BEARINGS ARE REFERENCED TO THE NORTH LINE OF THE SOUTHWEST 1/4 OF SECTION 9-3-15 AND IS ASSUMED TO BEAR N02°08'41"W, (NAD83).

10557 SQ. FT.
0.24 ACRE

- FOUND 3/4" IRON ROD
- FOUND 1 1/4" O.D. IRON PIPE
- SET 1 1/4" O.D. IRON PIPE
- () RECORDED DIMENSIONS

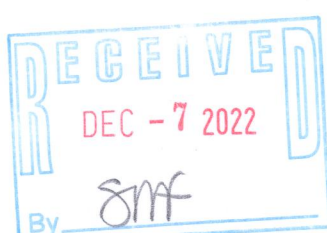

"I hereby certify that I have surveyed the above property and that the above map is a true representation thereof and shows the size and location of the property, its exterior boundaries, the location of all visible structures and dimensions of all principal buildings thereon, boundary fences, apparent easements, roadways and encroachments if any."

"This survey is made for the use of the present owners of the property, and also those who purchase, mortgage or guarantee the title thereto within one year from date hereof."

Kettle Moraine Surveying Inc.
P.O. Box 357
Eagle WI. 53119
(262) 594-3484
kettlemorainesurveying.com



THIS IS NOT AN ORIGINAL SURVEY UNLESS THE SEAL IS RED.

6/2/2022
DATE

TEP
FIELD WORK BY

TEP
DRAWN BY

22050
JOB NUMBER

CS-125

315 1450