


DUNHAM SURVEYING, S. C.  
SURVEYING & SUBDIVIDING  
DELAVER, WISCONSIN 53115

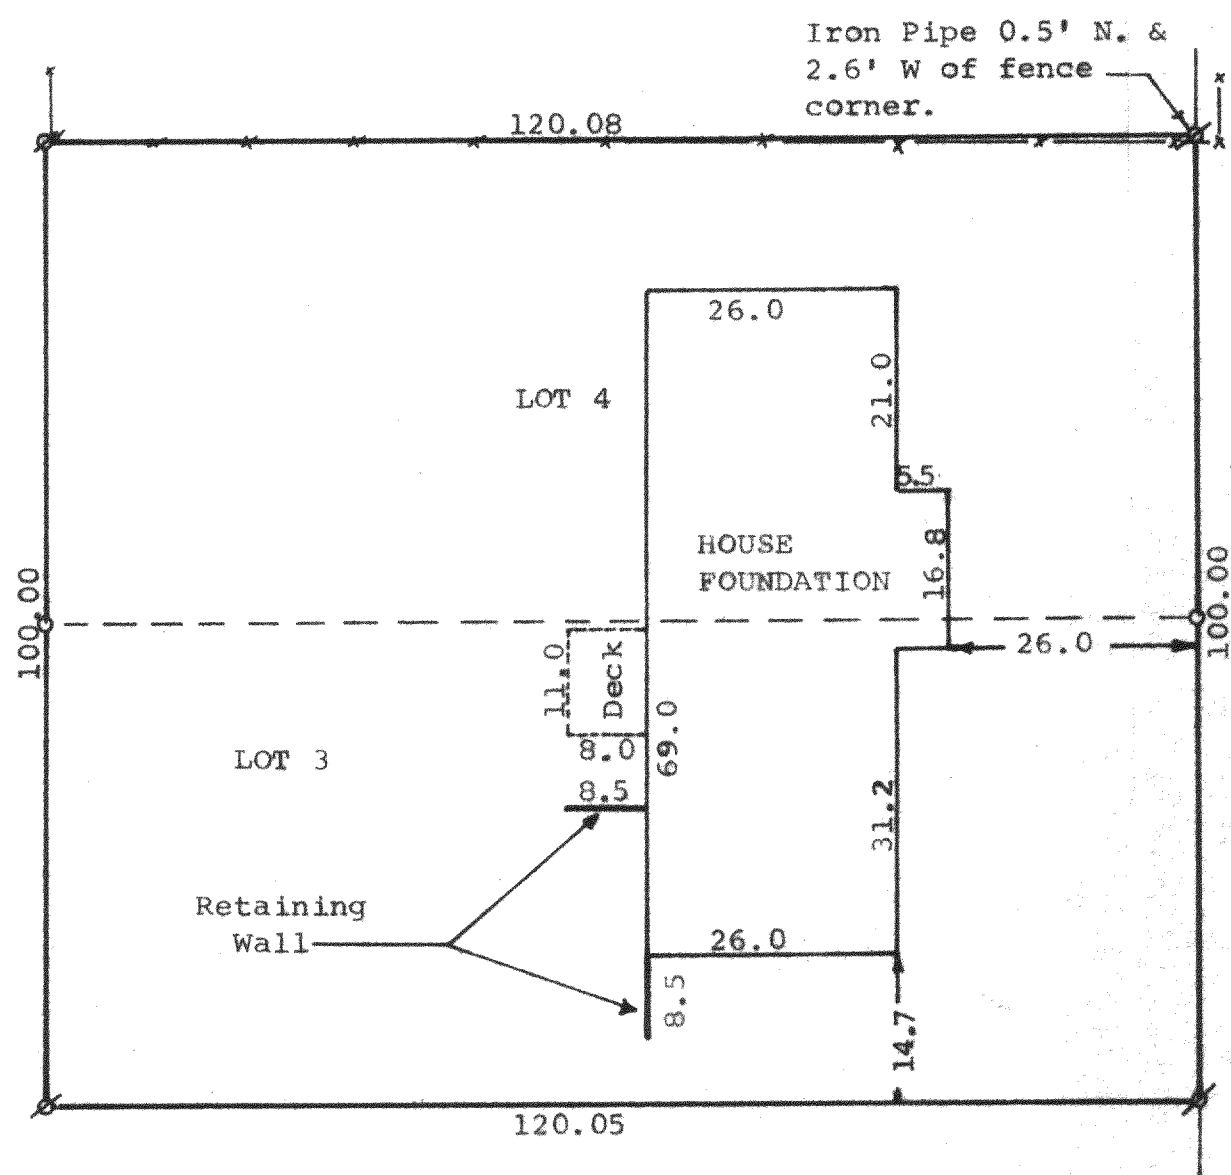

Scale - 1" = 20'  
 ∅ = Iron Rod Found & Reset with Iron Pipe  
 o = Iron Rod Found  
 -x-x- = Fence Line

STATE OF WISCONSIN)  
COUNTY OF WALWORTH) SS

I, George T. Dunham, Surveyor, certify that I have surveyed the property described as follows,

Lots 3 and 4, Block "J" of Crystal Bowl, a subdivision located in Sections 12 and 13, T 3 N, R 15 E, Walworth County, Wisconsin, and the above map is a true representation thereof and shows the size and location of the property, its exterior boundaries, the location and dimensions of all structures thereon, fences, apparent easements and roadways and visible encroachments, if any.

This survey is made for the exclusive use of the present owners of the property, and also those who purchase, mortgage, or guarantee the title thereto within one (1) year from date hereof; and as to them I warrant the accuracy of said survey and map.

April 5, 1977

Proposed House Added 6/16/79

*George T. Dunham*  
George T. Dunham, Surveyor

In addition, I, George T. Dunham, Surveyor, certify that on August 20, 1979 I located the foundation for the house on the above described property, and that the above map is a true representation thereof and shows the location and dimensions of said foundation.

August 20, 1979

*George T. Dunham*  
George T. Dunham, Surveyor

