
GEORGE T. DUNHAM SURVEYING & SUBDIVIDING DELAYAN, WISCONSIN

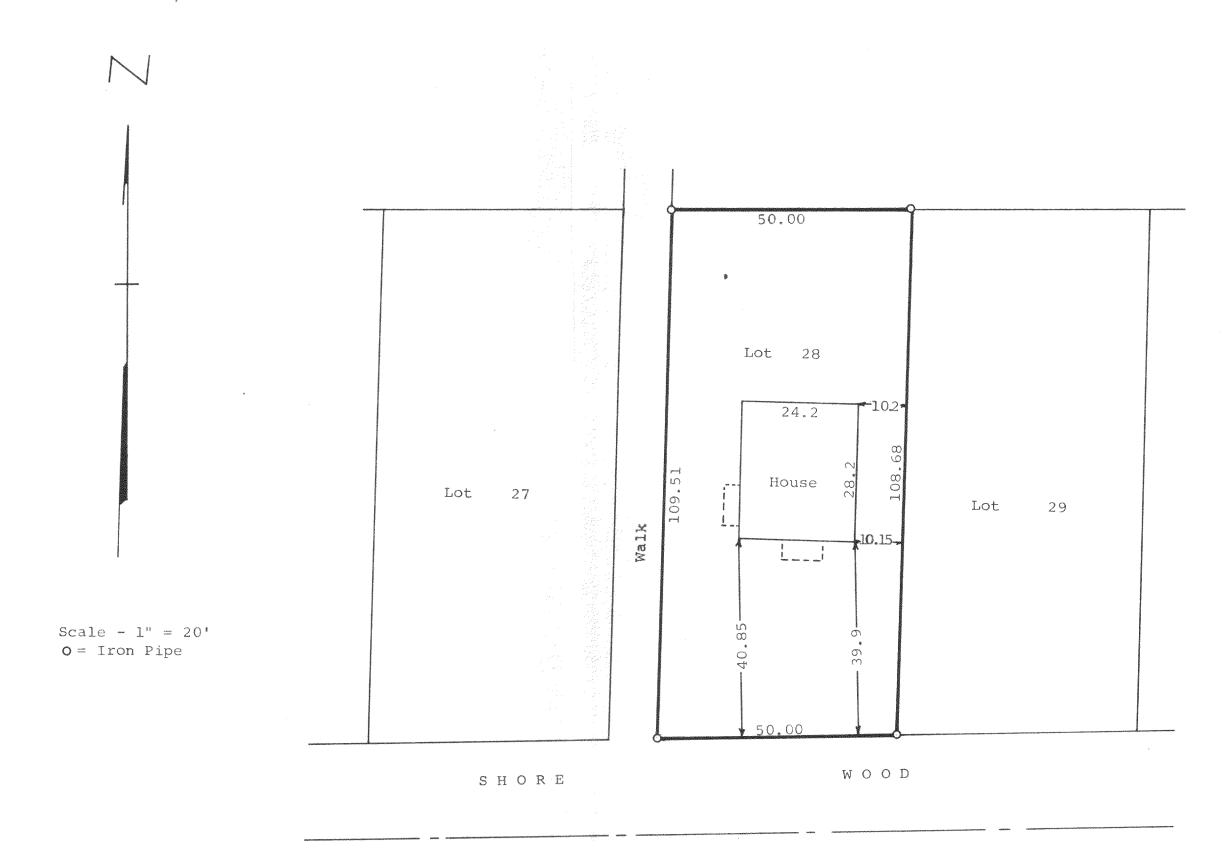

TERRACE

STATE OF WISCONSIN) SS WALWORTH COUNTY,)

I, George T. Dunham, Surveyor, certify that I have surveyed the property described as follows

have surveyed the property described as follows, Lot 28, Block "A" of Crystal Bowl, a subdivision

located in Sections 12 and 13, T 3 N, R 15 E,

Walworth County, Wisconsin.

and the above plat is an accurate survey and a true representation thereof and correctly shows the exterior boundary lines and location of buildings on said property

and the correct measurements thereof. October 12, 1967

George T. Dunham, Surveyor

C C R - 15