


#101-68

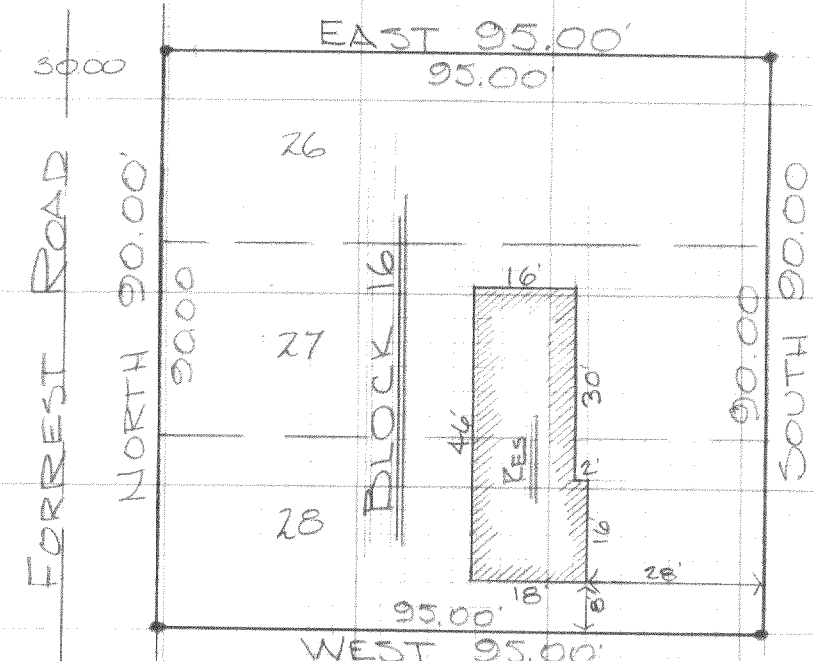


• INDICATES IRON PIPE

DESCRIPTION: Lots 26, 27, and 28 of Block 16 of Skansen Subdivision, located in the SW $\frac{1}{4}$ of Section 9, T. 3 N., R. 15 E., Walworth County, Wisconsin.

CERTIFICATE: I, James F. Biagi, surveyor, do hereby certify that I have surveyed the property hereon described, and that the location of the improvements are as shown.

August 10, 1968.

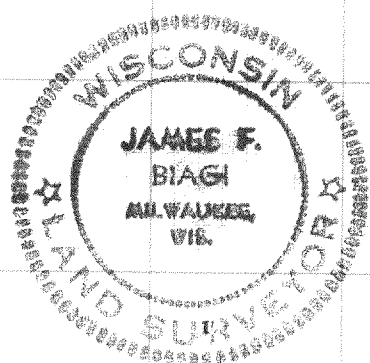

James F. Biagi