


PLAT OF SURVEY

BLOCK 14, LOTS 22, 23, 24, AND 25, SKANSEN'S SUBDIVISION SOUTH PART

SUBDIVISION LOCATED IN THE S.W. 1/4 OF SECTION 9
T3N, R15E, WALWORTH COUNTY, WISCONSIN

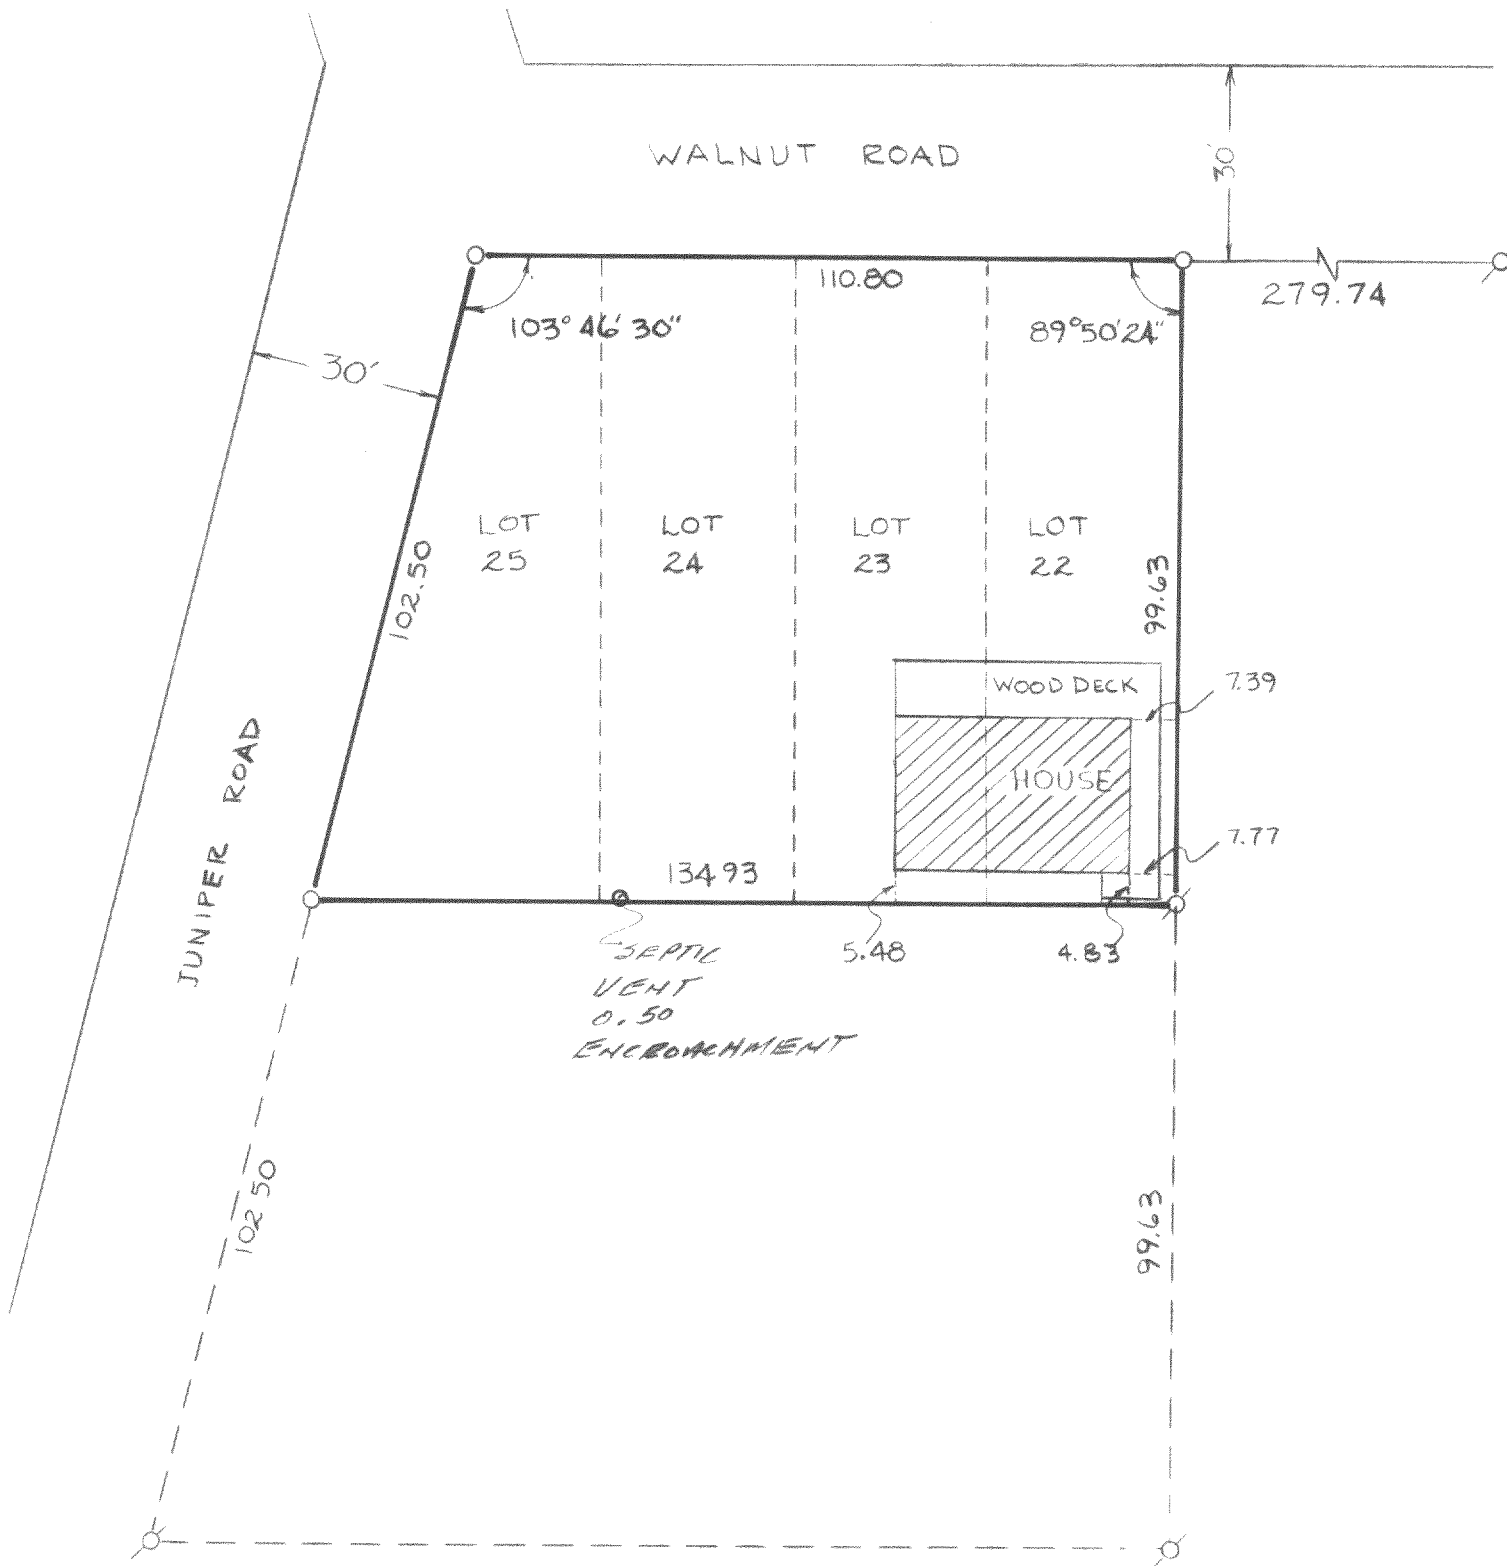

ASSUMED NORTH

JENSEN SURVEYING & MAPPING S.C.

P.O. BOX 322

ELKHORN WIS. 53121-0322 (414) 723-3434

SURVEYED BY: THOMAS P.A. JENSEN RLS-1084

DRAFTED BY: R.L. MEADOWS

SURVEYED FOR: STAN HARE

RT#2 BOX 133


ELKHORN, WISC. 53121

SCALE 1" = 30'

LEGEND

- IRON PIPE FOUND
○ IRON PIPE PLACED

I HEREBY CERTIFY THAT THE ABOVE DESCRIBED PROPERTY HAS BEEN SURVEYED UNDER MY DIRECTION AND THAT THE PLAT HEREON DRAWN IS A CORRECT REPRESENTATION OF SAID SURVEY, AND CORRECTLY SHOWS THE EXTERIOR BOUNDARIES AND DIVISIONS AND THE HOUSE THEREON.

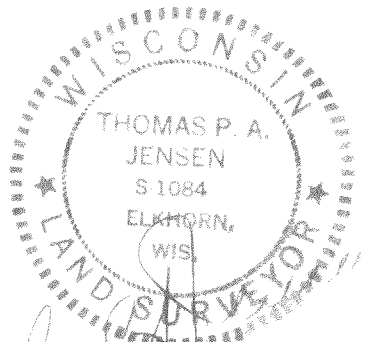

198107C
315-182J ✓