


JENSEN SURVEYING & MAPPING
P.O. BOX 322
ELKHORN, WI. 53121

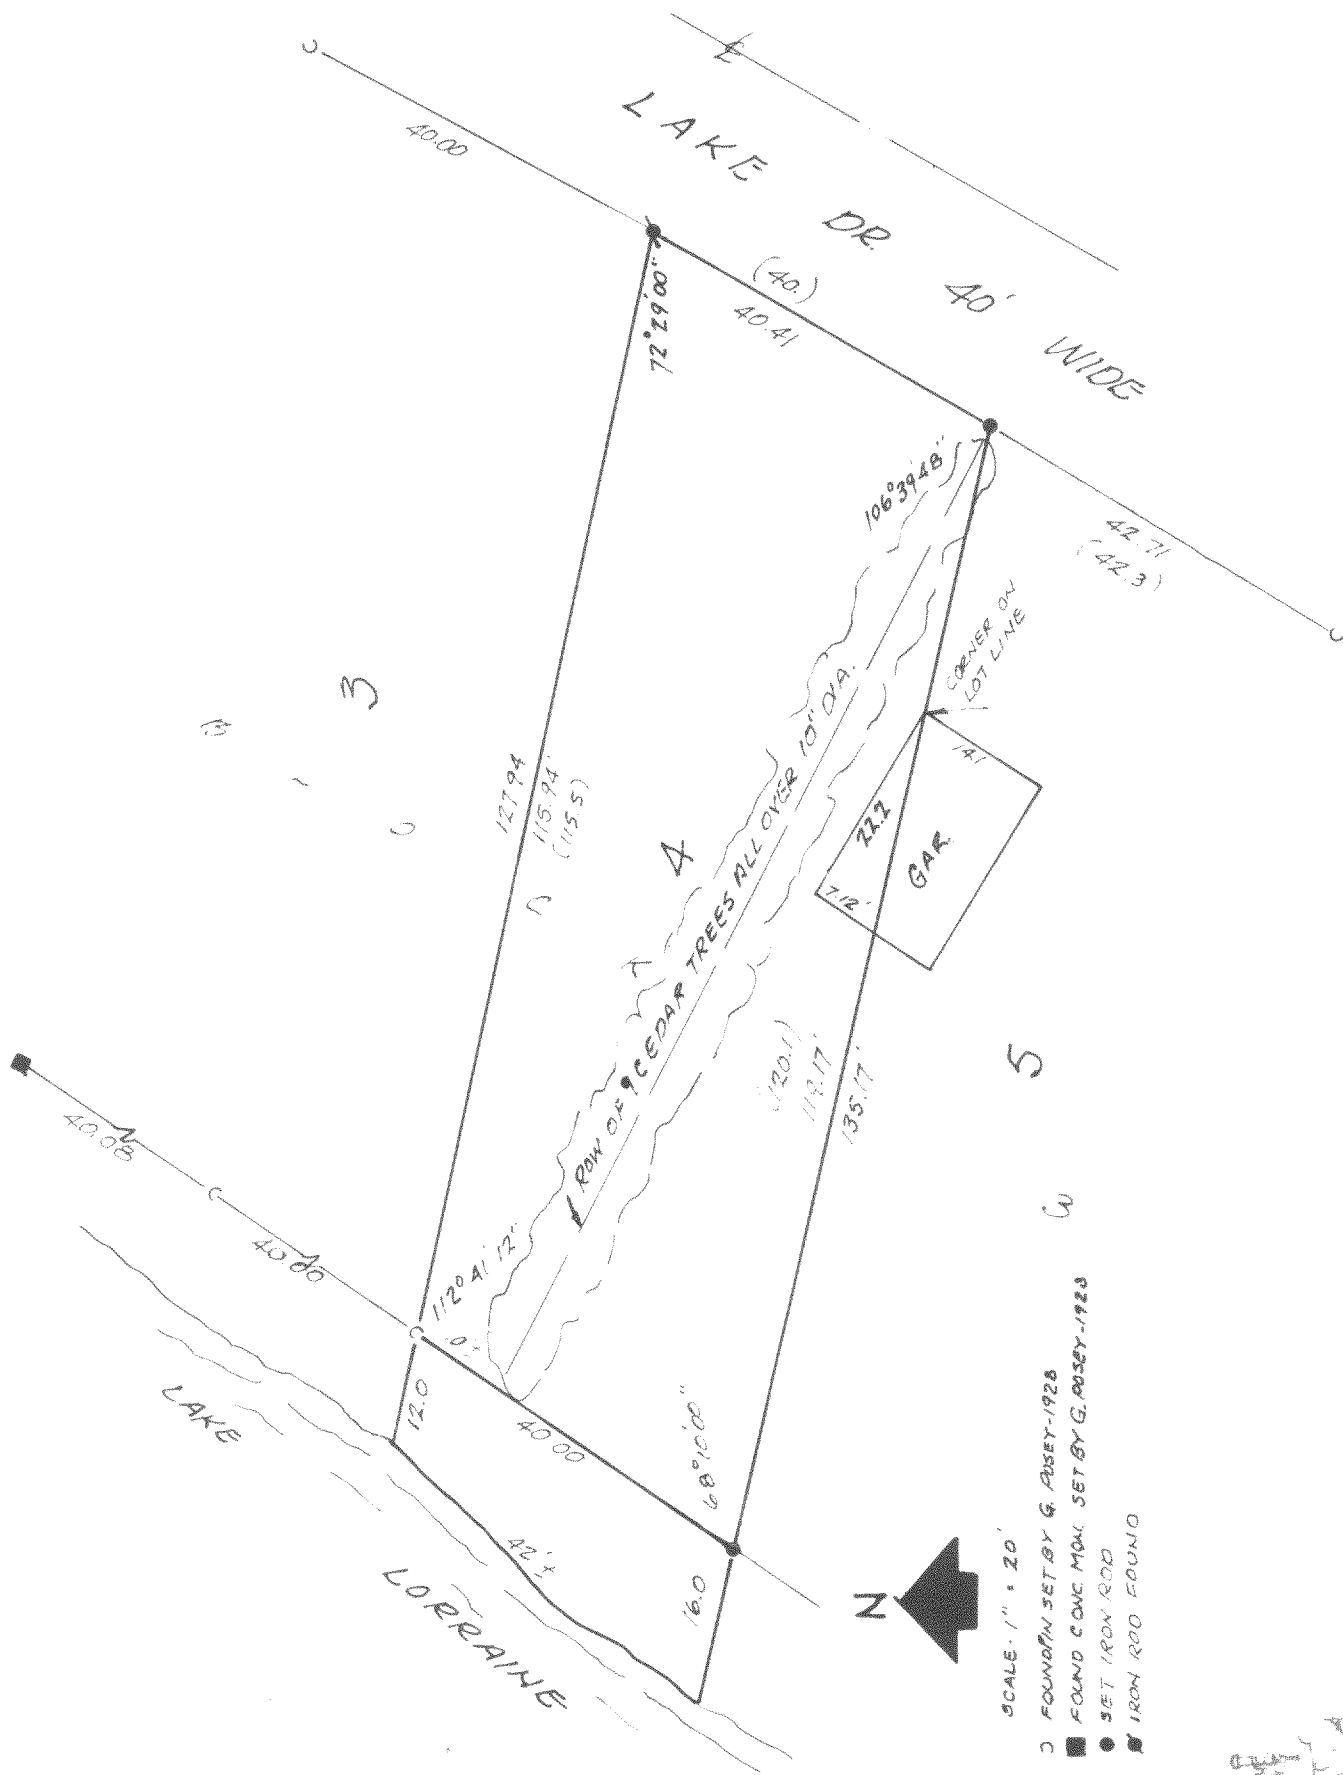

SUBMITTED FOR: L. ROAMS
2184 ROMAN CT.
SCHOMBURG, IL. 60194

PLAT OF SURVEY OF
LOT 4, BLOCK 3, FORREST BEACH SUB.
LOCATED IN THE N.W. 1/4 SECTION 9, T3N, R15E,
WALWORTH COUNTY, WISCONSIN.

I HEREBY CERTIFY THAT I HAVE SURVEYED THE ABOVE DESCRIBED PROPERTY AND THAT THE PLAT SHOWING HEREON IS AN ACCURATE SURVEY AND CORRECTLY SHOWS THE EXTERIOR BOUNDARY LINES ON SAID PROPERTY AND THE CORRECT MEASUREMENTS THEREOF AND BUILDINGS THEREON.

THOMAS P. A. JENSEN, R.L.S. 1084

DATE: June 124 1983

CFB-13A

1983.131