

PLAT OF SURVEY OF

LOTS 3 AND 4, OAKKNOLL SUBDIVISION LOCATED IN
THE NORTH 1/2 OF SECTION 3, T3N, R15E TOWN OF RICHMOND
WALWORTH COUNTY, WISCONSIN.

SURVEYED BY:


JENSEN SURVEYING & MAPPING S.C.

P.O. BOX 322 ELKHORN, WISCONSIN 53121 45 S. WISCONSIN ST.



PHONE (414) 723-3434 53121

SURVEYED FOR: RON KLUCZYNSKI

RT#3 KRAHN DRIVE
WHITEWATER, WISCONSIN
53190

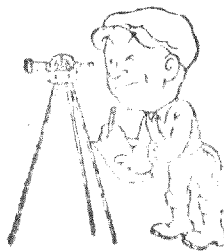

KRAHN DRIVE 66' WIDE PUBLIC

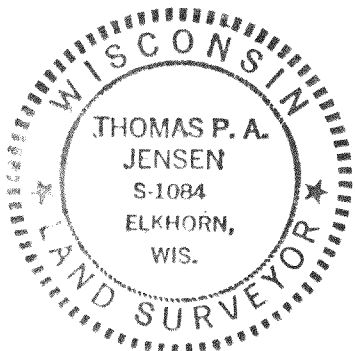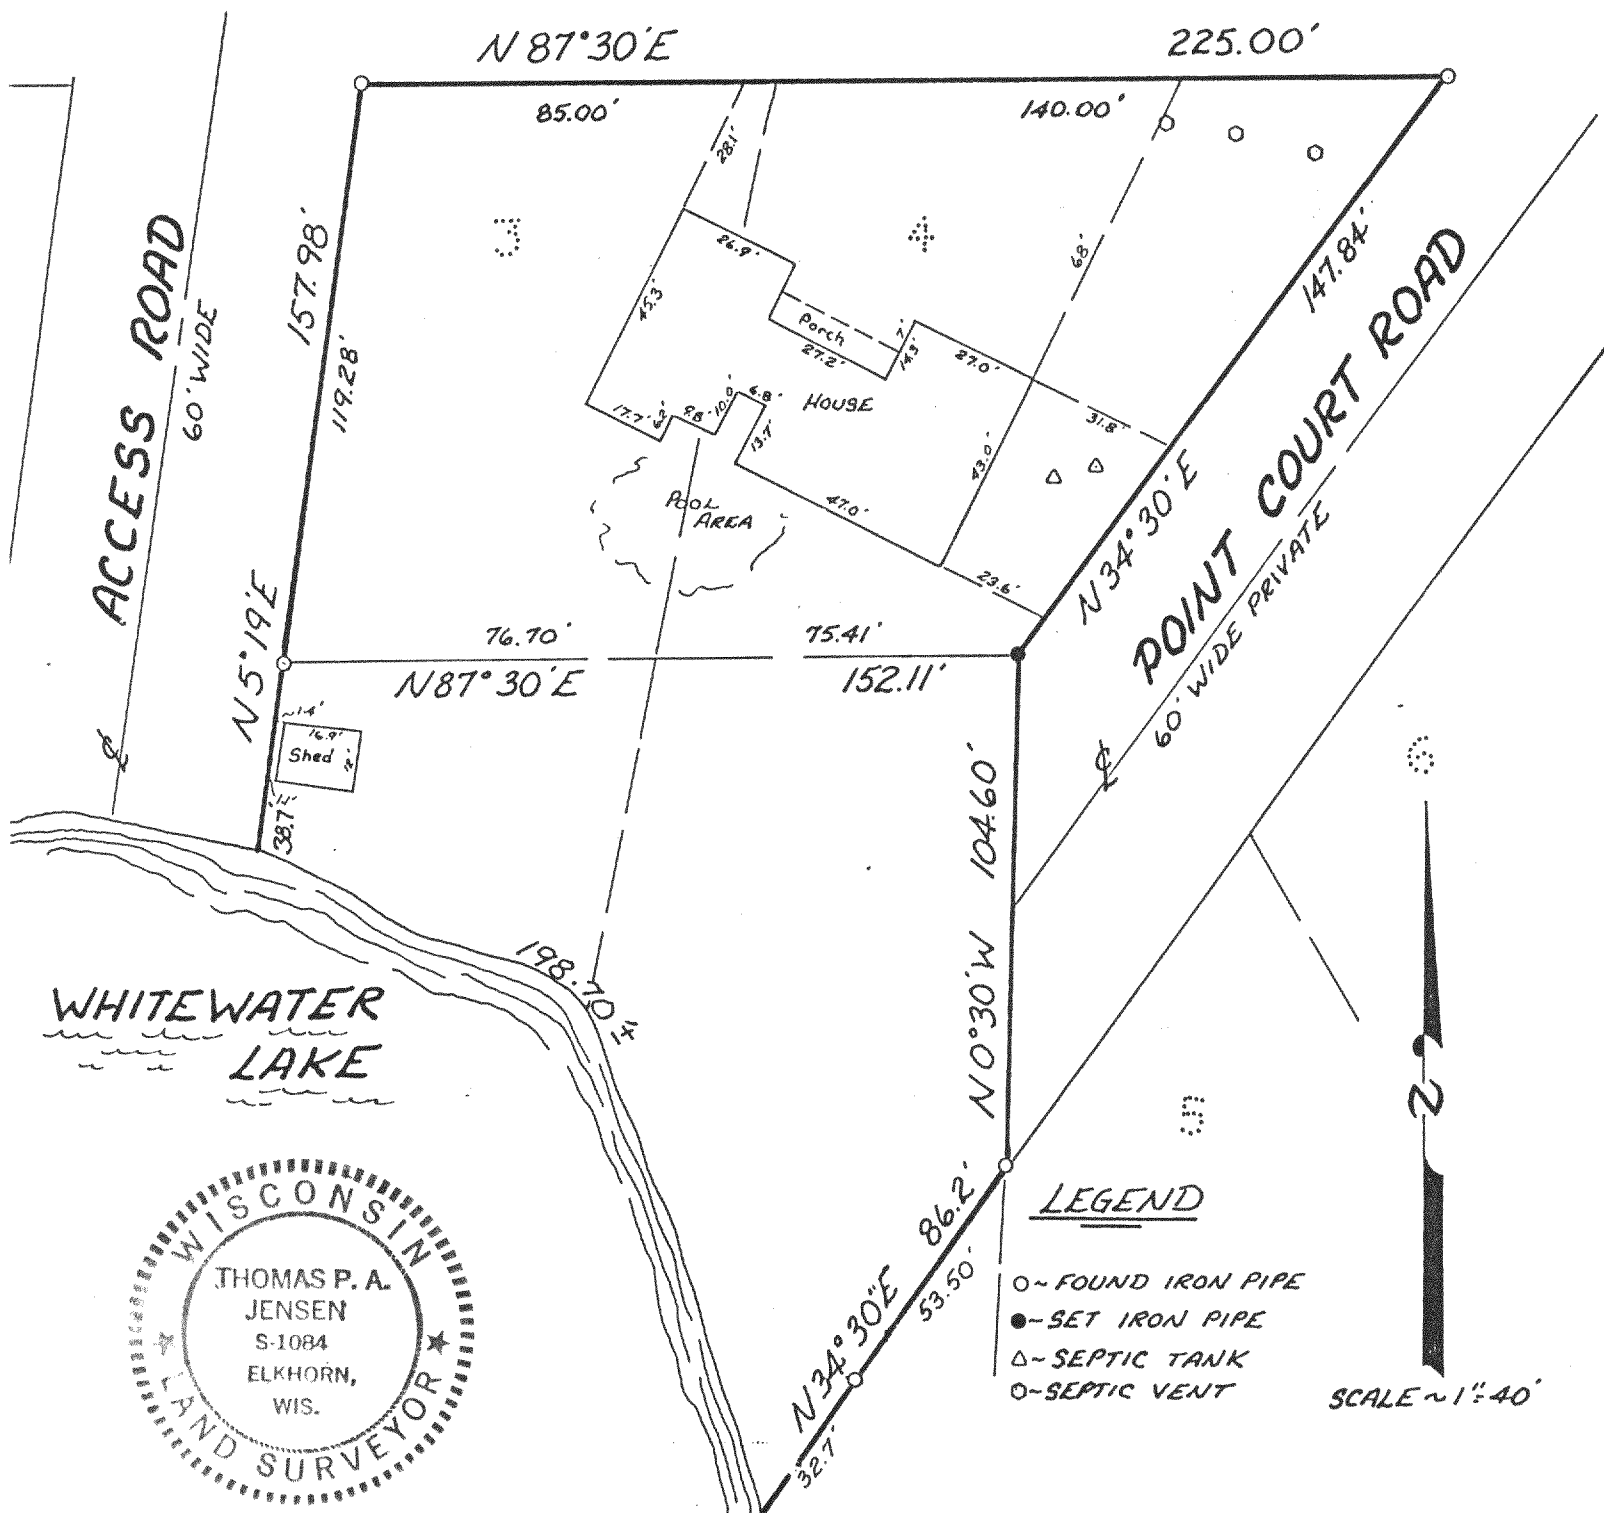

I HEREBY CERTIFY THAT THE ABOVE DESCRIBED
PROPERTY HAS BEEN SURVEYED UNDER MY DIRECTION, THAT THE PLAT
SHOWN HEREON IS AN ACCURATE SURVEY, A TRUE REPRESENTATION THEREOF
CORRECTLY SHOWS THE EXTERIOR BOUNDARY LINES ON SAID PROPERTY AND
THE CORRECT MEASUREMENTS THEREOF AND BUILDINGS THEREON.

Thomas P. A. Jensen
THOMAS P. A. JENSEN RLS-1084
315-210

MAPPING DATE: 18 OCT 84

COK-3
1984.069