
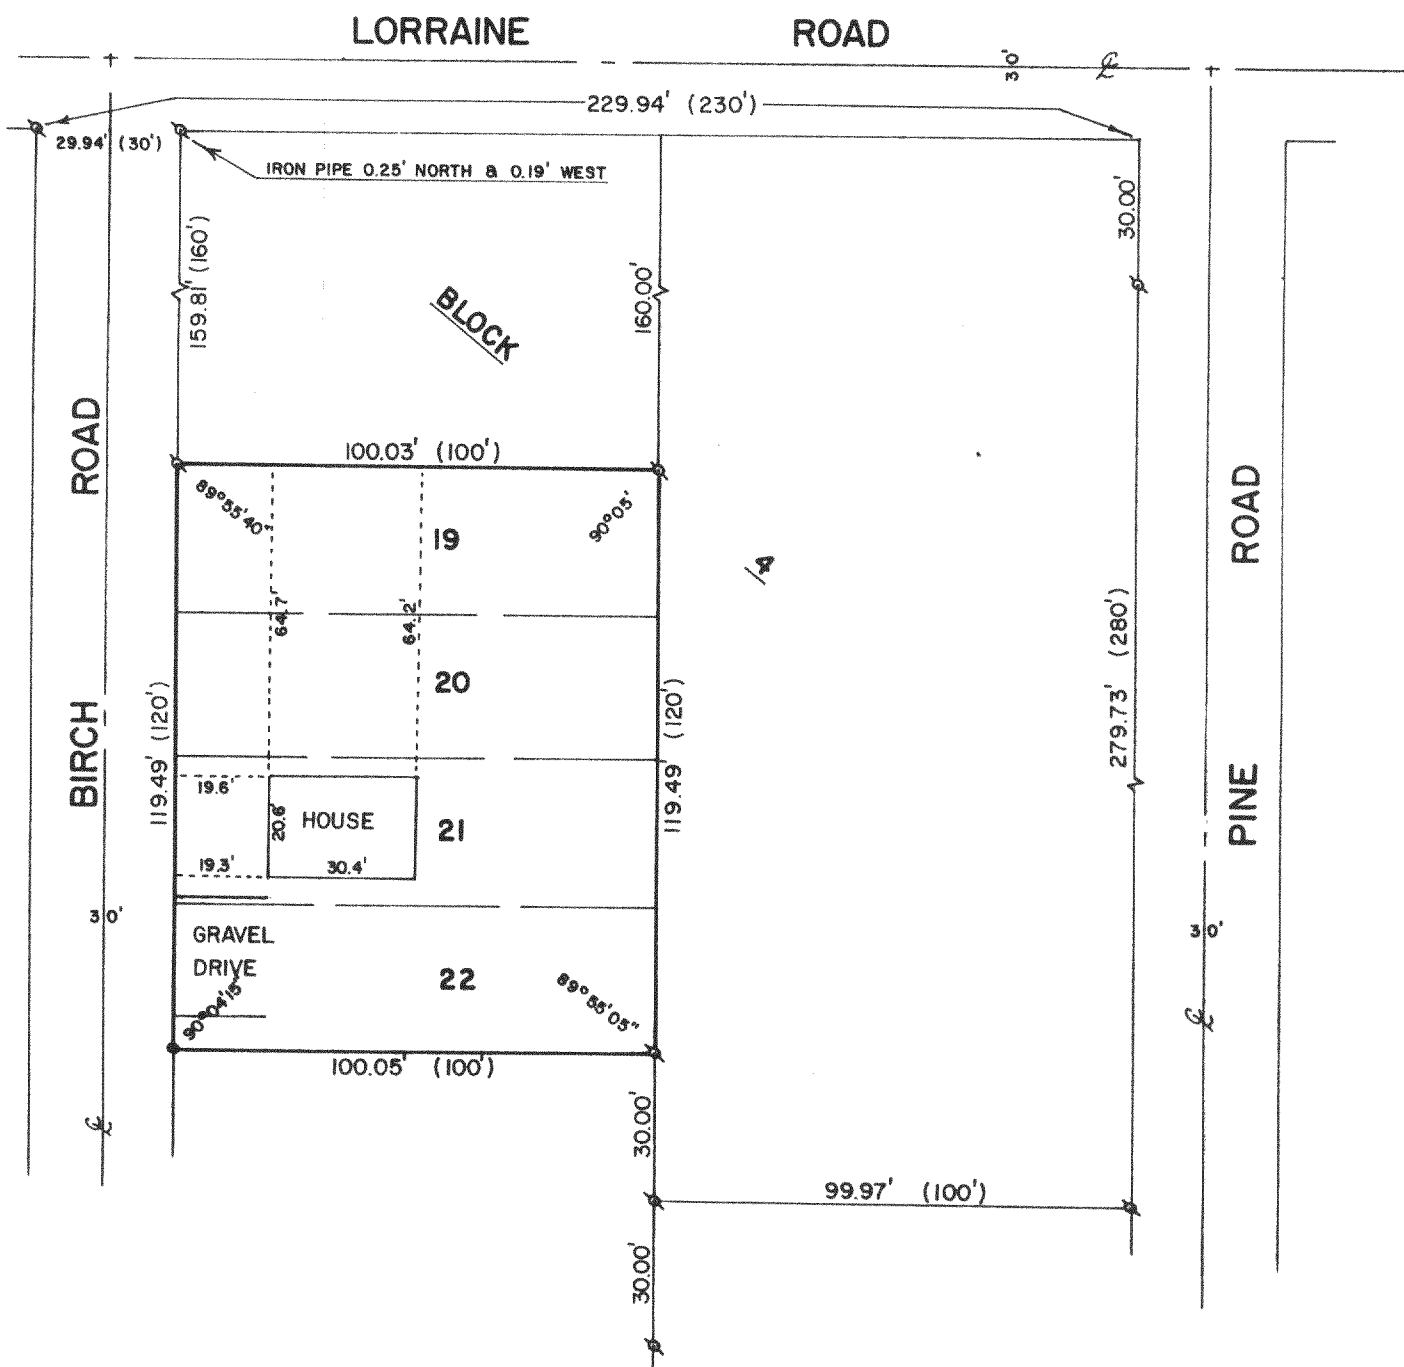


ABELL
SURVEYING & MAPPING
 DELAVAN, WISCONSIN 53115
 414-728-6737

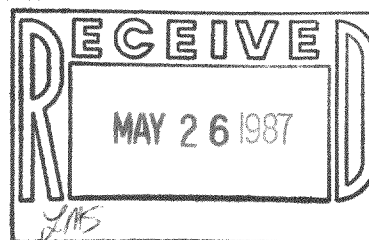

PLAT OF SURVEY OF

LOTS 19-22, BLOCK 4, SKANSEN SWEDISH TRIBUNE-NEWS
 SUBDIVISION, T3N, R15E, WALWORTH COUNTY, WISCONSIN.

ORDERED BY: CENTURY 21 GENEVA LAKE
 503 CENTER STREET
 LAKE GENEVA, WI 53147



SCALE - 1"=40'

- LEGEND
 x - IRON PIPE FOUND
 • - IRON ROD SET
 () - RECORDED AS

I, DAVID F. ABELL, DO HEREBY CERTIFY
 THAT I HAVE SURVEYED THE PROPERTY
 HEREON DESCRIBED ACCORDING TO THE
 OFFICIAL RECORDS AND THAT THE PLAT
 HEREON IS A CORRECT REPRESENTATION
 OF THE PROPERTY LINES TO THE BEST OF
 MY KNOWLEDGE AND BELIEF.

David F. Abell
 DAVID F. ABELL
 WISCONSIN REGISTERED LAND SURVEYOR, S-1596

DATE *April 25, 1987*
 JOB NUMBER - 87044
 NOTE: THIS IS NOT A CERTIFIED COPY UNLESS SEALED.

CS-75,76,77

315-230