


DUNHAM SURVEYING, S.C.
SURVEYING & SUBDIVIDING
DELAVER, WISCONSIN 53115

ETHELYN

DRIVE

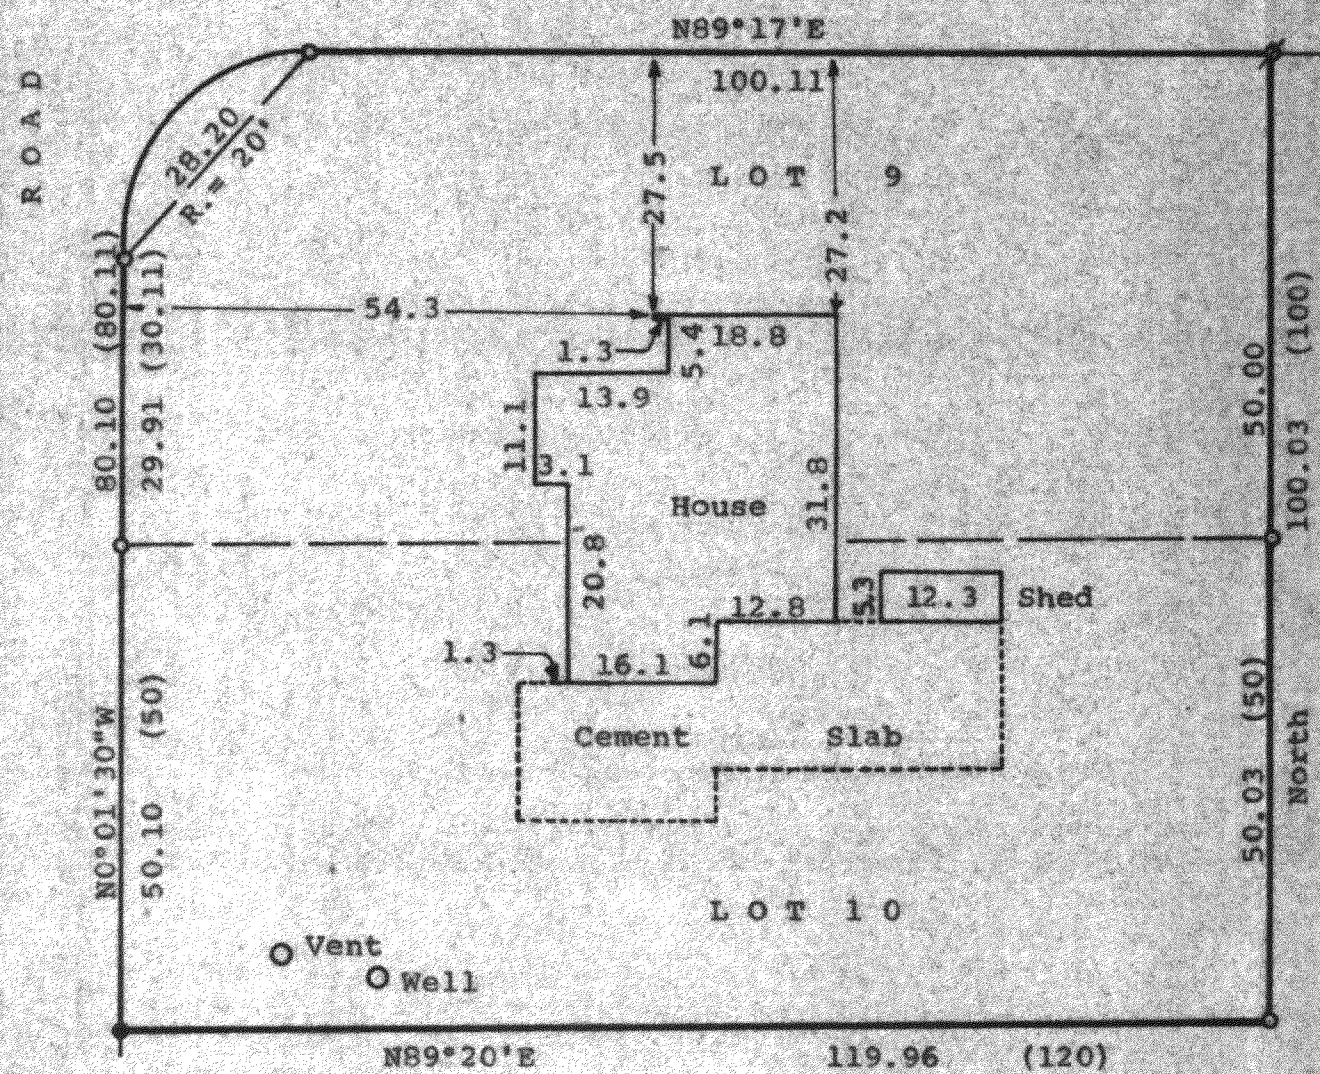

Scale - 1" = 20'

• = 1" Dia. Iron Rod Found

○ = 5/8" Dia. Iron Rod Found

⊗ = 5/8" Dia. Iron Rod Found Bent
and reset with 3/4"x24" Iron Pipe

(000) = Recorded Distance

Bearings are based on the East line of
property surveyed, assumed bearing of
North.

Survey Ordered By:

Century 21

Skandia Realty


312 S. 7th Street

Delavan, WI 53115

STATE OF WISCONSIN) SS
COUNTY OF WALWORTH)

I, George T. Dunham, Surveyor, certify that I have surveyed the
property described as follows,

Lots 9 and 10, Block "K" located in Crystal Bowl, a subdivision
located in Sections 12 and 13, T3N, R15E, Walworth County, Wisconsin,
and that the map shown hereon is a correct representation thereof and shows
the size and location of the property, its exterior boundaries, the location
of all visible structures and dimensions of all principal buildings thereon,
boundary fences, apparent easements, roadways and visible encroachments, if
any, and that I have surveyed the property hereon described according to the
official records, to the best of my knowledge and belief.
March 15, 1988.

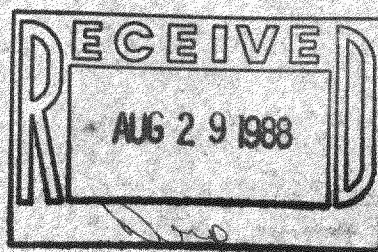

George T. Dunham
George T. Dunham, Surveyor

