
GEORGE T. DUNHAM SURVEYING & SUBDIVIDING DELAYAN, WISCONSIN

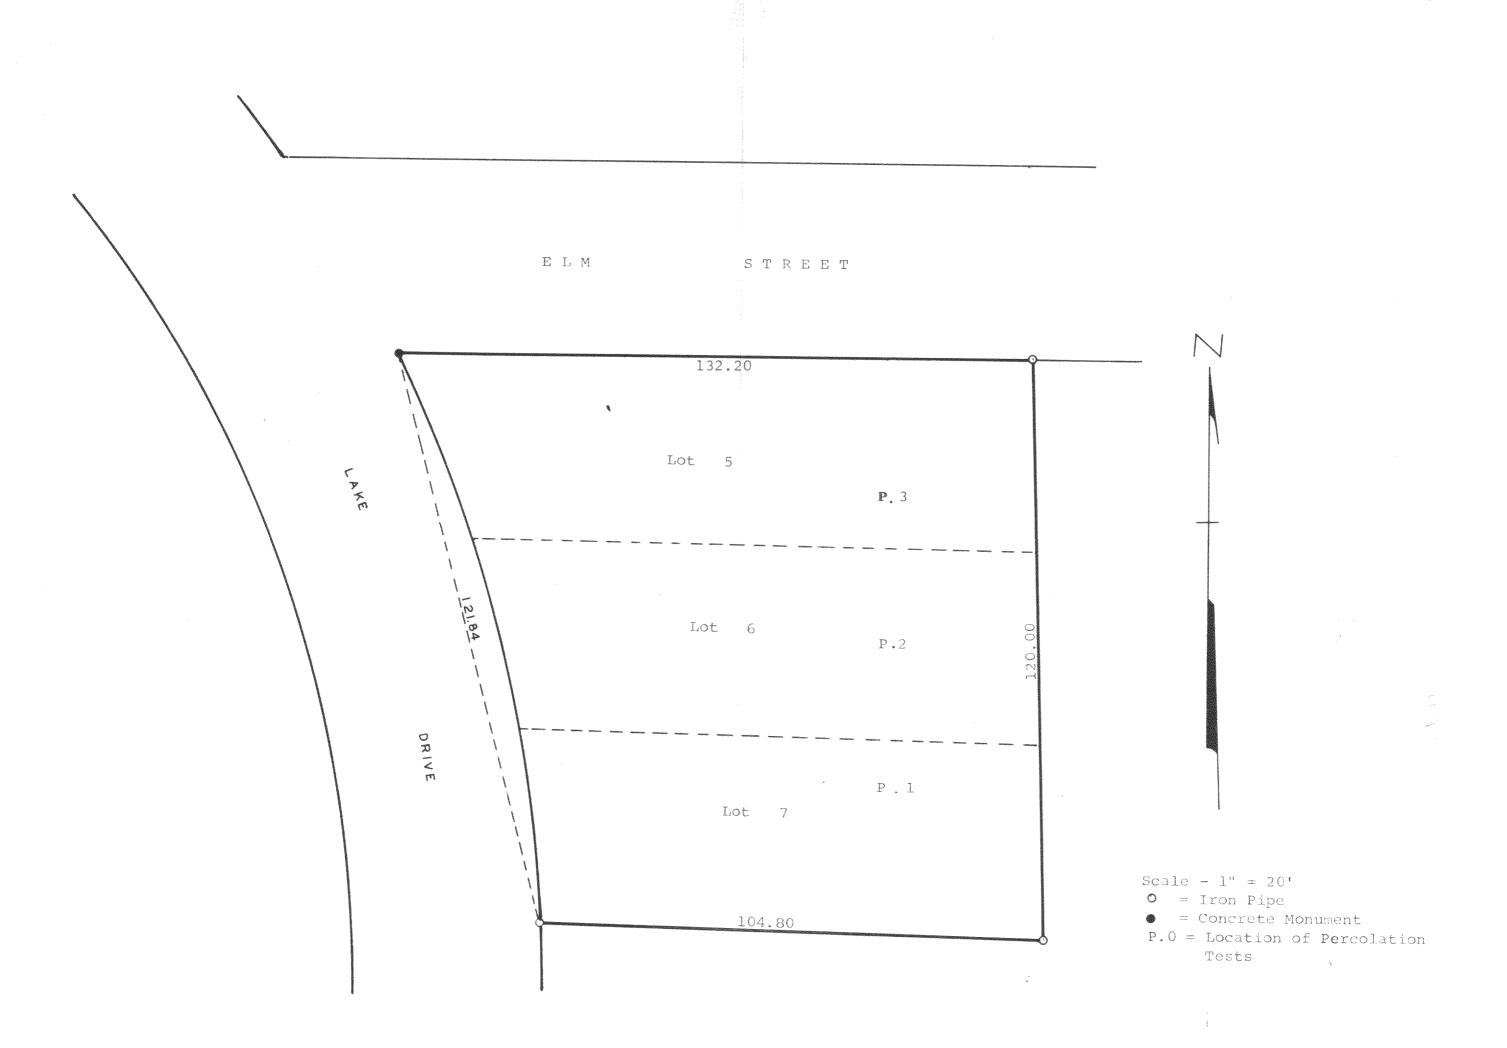

Plat of survey of Lots 5, 6, & 7, Block 10 in Forest Beach, a subdivision located in Section 9, T 3 N, R 15 E, Walworth County, Wisconsin. Also the location of the percolation tests made on said lots.

March 27, 1969

George T. Dunham, Surveyor

CFB-64

315-31