

SCALE 1"=20'

LEGEND

- ⊙ - IRON PIPE FOUND
- - IRON ROD FOUND
- △ - UTILITY POLE
- ⌒ - UTILITY POLE ANCHOR
- - OVERHEAD UTILITY LINES
- CS - CONCRETE STOOP
- ▲ - YARD LIGHT
- ( ) - RECORDED AS


**ABELL  
SURVEYING & MAPPING**

DELAVAN, WISCONSIN 53115

414-728-6737

ORDERED BY: SKY DAVIES  
129 S. 3rd  
DELAVAN, WI. 53115

**PLAT OF SURVEY OF**  
LOTS 4, 5, 27 & 28, BLOCK "F" OF CRYSTAL  
BOWL SUBDIVISION, LOCATED IN T3N. R1E.  
WALWORTH COUNTY, WISCONSIN.

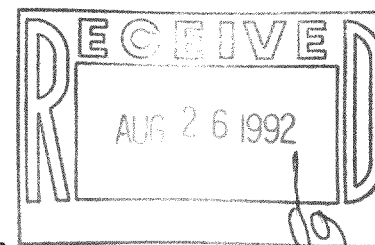

I HEREBY CERTIFY THAT I HAVE SURVEYED THE ABOVE DESCRIBED PROPERTY AND THAT THE ABOVE MAP IS A TRUE REPRESENTATION THEREOF AND SHOWS THE SIZE AND LOCATION OF THE PROPERTY, ITS EXTERIOR BOUNDARIES, THE LOCATION OF ALL VISIBLE STRUCTURES AND DIMENSIONS OF ALL PRINCIPAL BUILDINGS THEREON, BOUNDARY FENCES, APPARENT EASEMENTS, ROADWAYS AND VISIBLE ENCROACHMENTS, IF ANY, TO THE BEST OF MY KNOWLEDGE AND BELIEF.

THIS SURVEY IS MADE FOR THE USE OF THE PRESENT OWNERS OF THE PROPERTY, AND ALSO THOSE WHO PURCHASE, MORTGAGE, OR GUARANTEE THE TITLE THERETO WITHIN ONE (1) YEAR FROM DATE HEREON.

*David F. Abell*

DAVID F. ABELL  
WISCONSIN REGISTERED LAND SURVEYOR, S-1596

MAY 5, 1992

DATE: MAY 5, 1992 JOB NUMBER - 92087  
NOTE: THIS IS NOT A CERTIFIED COPY UNLESS SEALED.

35-347

CCR-100  
CCR-113