


GEORGE T. DUNHAM

SURVEYING & SUBDIVIDING
DELAVER, WISCONSIN

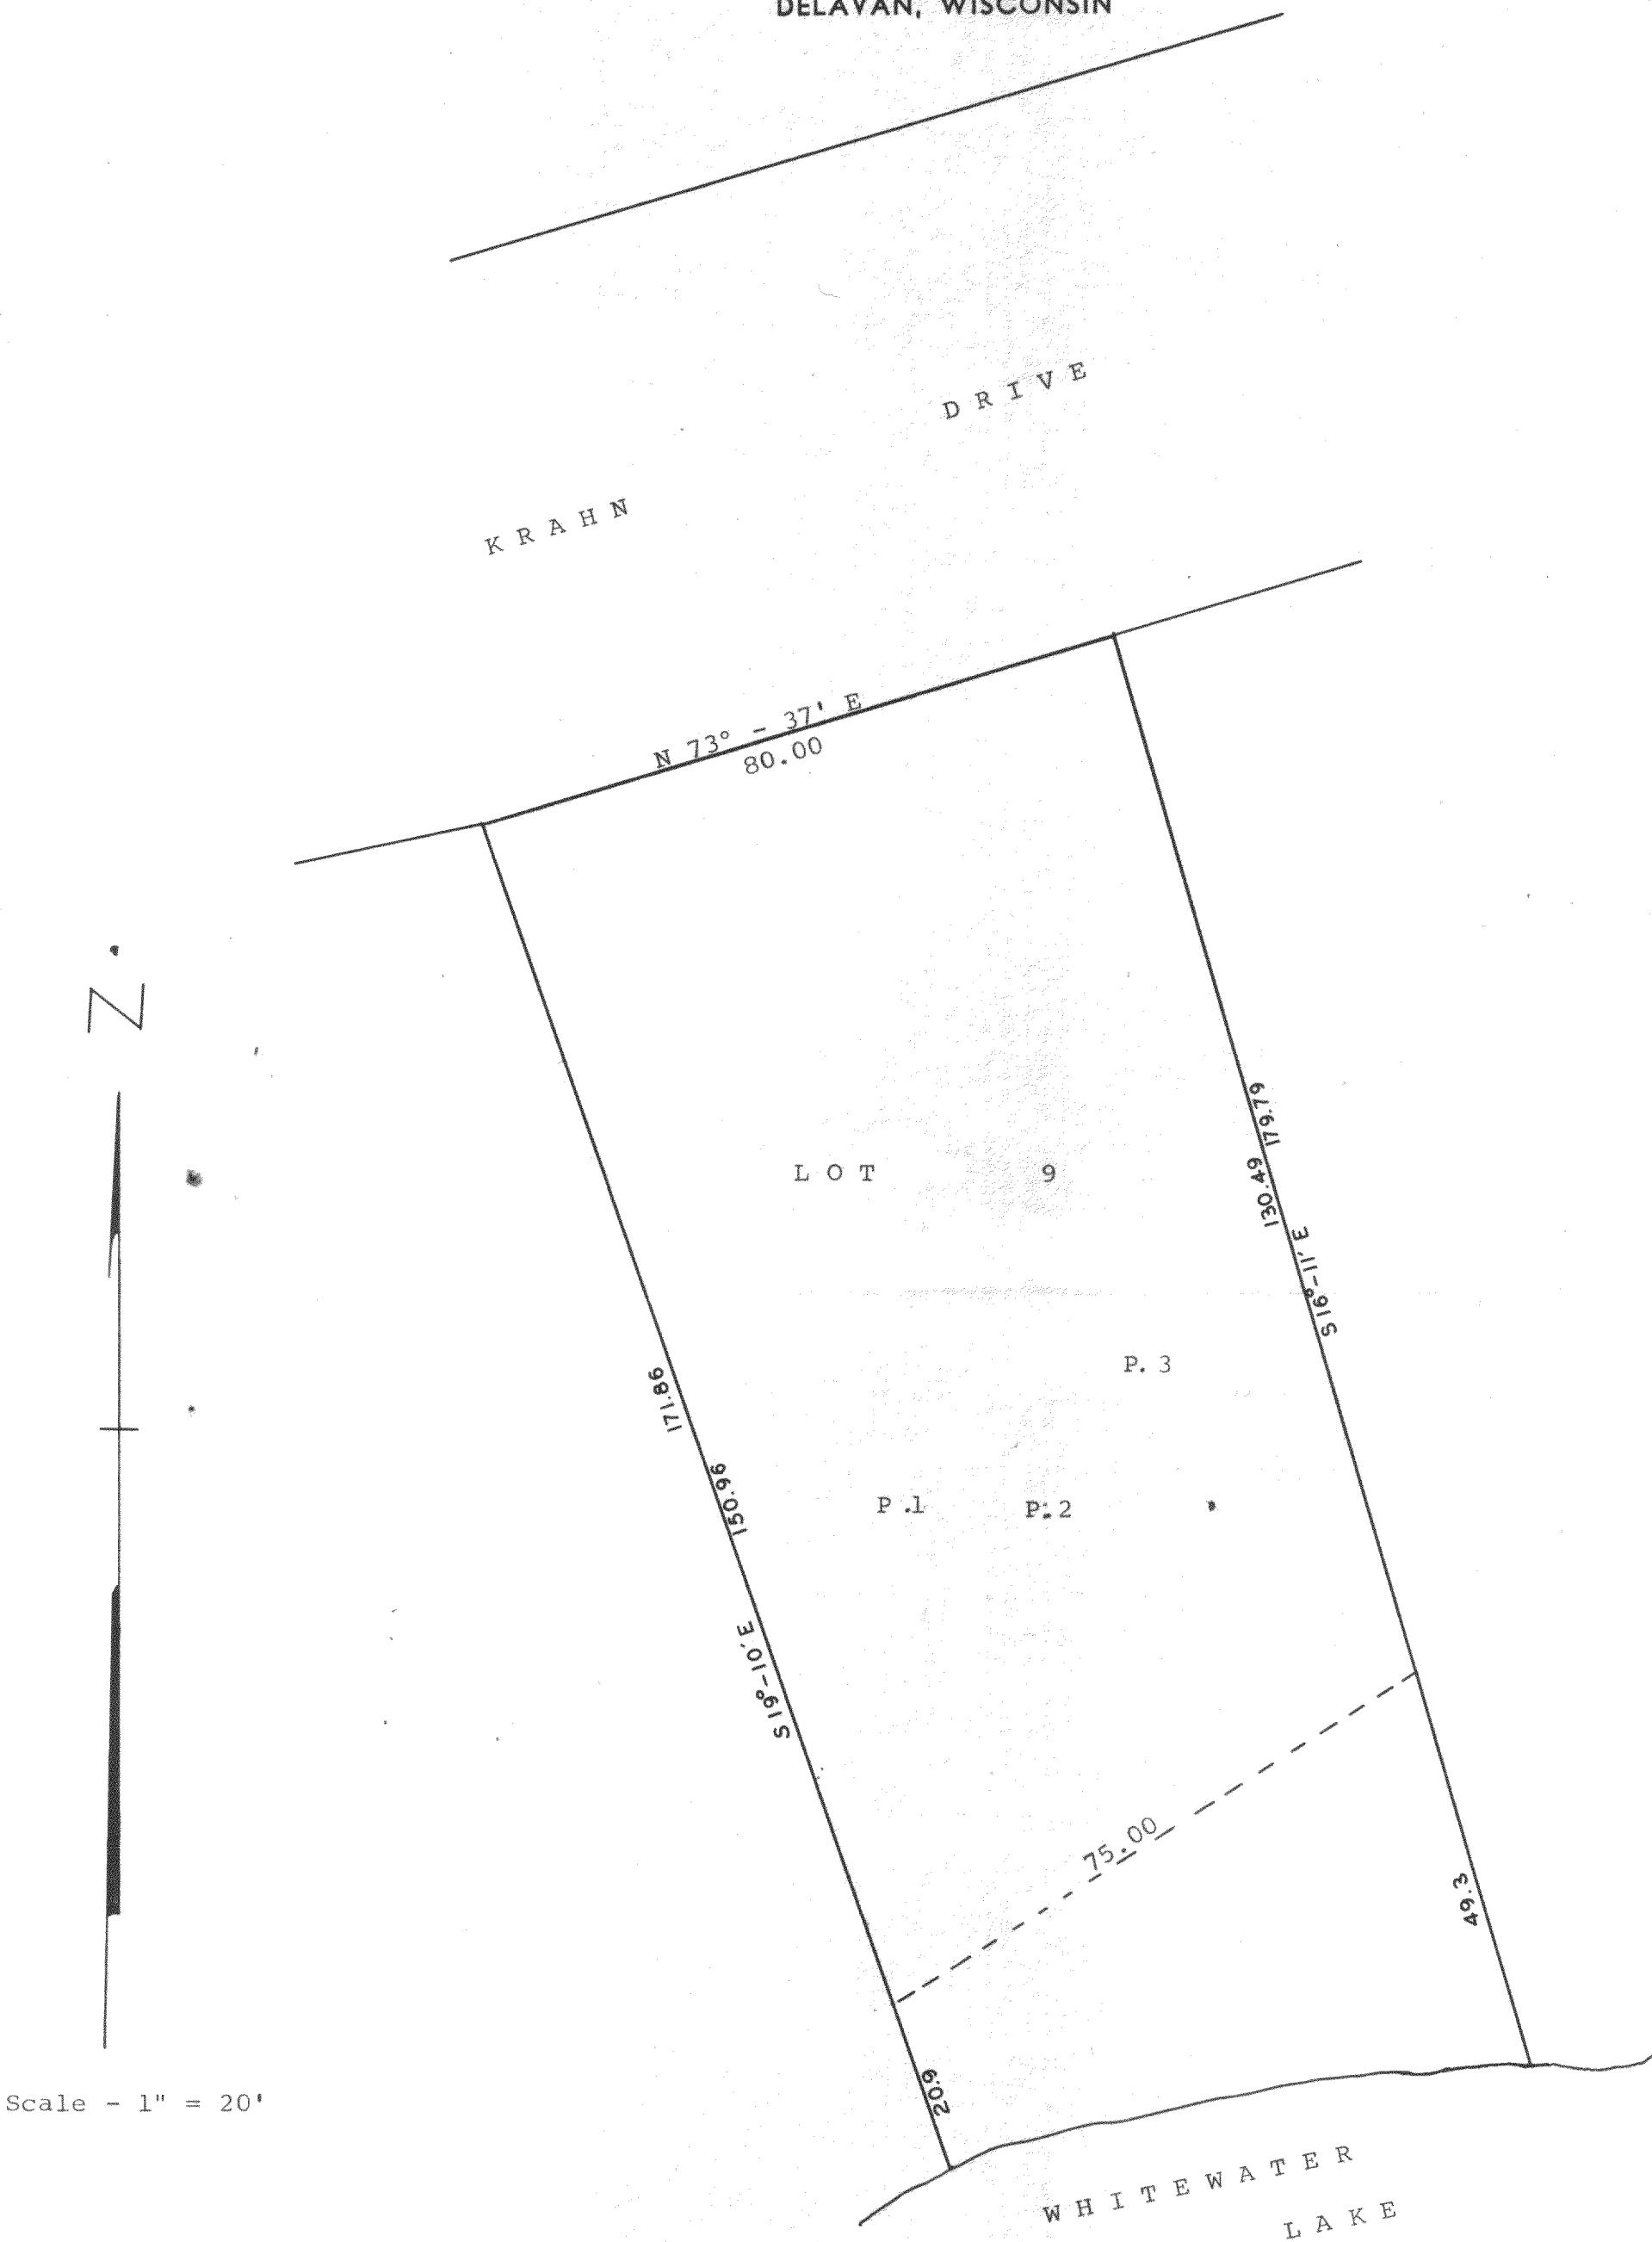

Plat showing the location of the percolation tests made
on Lot 9 of Oak Knolls, a subdivision located in the Town
of Richmond and Whitewater, Walworth County, Wisconsin.
Charles Kohlman, Owner
8/11/67

George T. Dunham
George T. Dunham, Surveyor

315-47