

# PLAT OF SURVEY OF


Tax Key No. CCR 00118 and CCR 00142

 $\mathcal{N}$ 

SCALE 1" = 20'

### LEGEND

- -IRON PIPE FOUND  
 ■ -IRON ROD FOUND  
 ○ -IRON ROD SET  
 △ -UTILITY POLE  
 ——— -OVERHEAD UTILITY LINES  
 ( ) -RECORDED AS

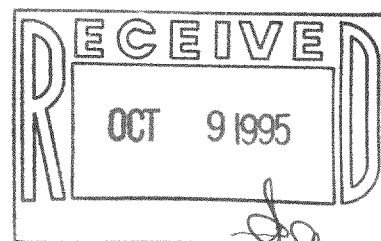

CCR-118  
CCR-142

315-495

BLOCK

ANDERSON  
DRIVE  
40 FEET WIDE

LOT 41

LOT 42

I HEREBY CERTIFY THAT I HAVE SURVEYED THE ABOVE DESCRIBED PROPERTY AND THAT THE ABOVE MAP IS A TRUE REPRESENTATION THEREOF AND SHOWS THE SIZE AND LOCATION OF THE PROPERTY, ITS EXTERIOR BOUNDARIES, THE LOCATION OF ALL VISIBLE STRUCTURES AND DIMENSIONS OF ALL PRINCIPAL BUILDINGS THEREON, BOUNDARY FENCES, APPARENT EASEMENTS, ROADWAYS AND VISIBLE ENCROACHMENTS, IF ANY, TO THE BEST OF MY KNOWLEDGE AND BELIEF.

THIS SURVEY IS MADE FOR THE USE OF THE PRESENT OWNERS OF THE PROPERTY, AND ALSO THOSE WHO PURCHASE, MORTGAGE, OR GUARANTEE THE TITLE THERETO WITHIN ONE (1) YEAR FROM DATE HEREON.

DAVID F. ABELL  
WISCONSIN REGISTERED LAND SURVEYOR, S-1596

July 25, 1995

DATE \_\_\_\_\_ JOB NUMBER - 95120  
NOTE: THIS IS NOT A CERTIFIED COPY UNLESS SEALED.