
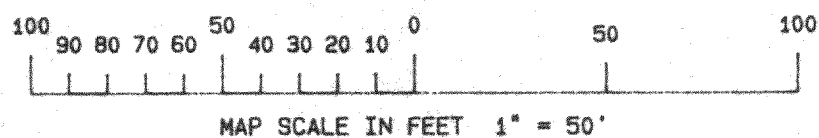


FARRIS, HANSEN & ASSOCIATES, INC.
 ENGINEERING, ARCHITECTURE, SURVEYING
 7 RIDGWAY COURT - P.O. BOX 437, ELKHORN, WISCONSIN 53121
 PHONE: (414) 723-2098 FAX: (414) 723-5886

PLAT OF SURVEY
 LOT 1 CERTIFIED SURVEY MAP NO. 1947
 LOCATED IN SE 1/4 OF SEC. 3, TOWN 3 NORTH, RANGE 15 EAST
 WALWORTH COUNTY, WISCONSIN

WORK ORDERED BY: TOM MARSHALL
 816 HAZEL RIDGE ROAD, APT. 402
 ELKHORN, WISCONSIN 53121

- = FOUND IRON PIPE STAKE
- = FOUND IRON REBAR STAKE
- ✕ = FOUND NAIL
- (---) = RECORDED AS

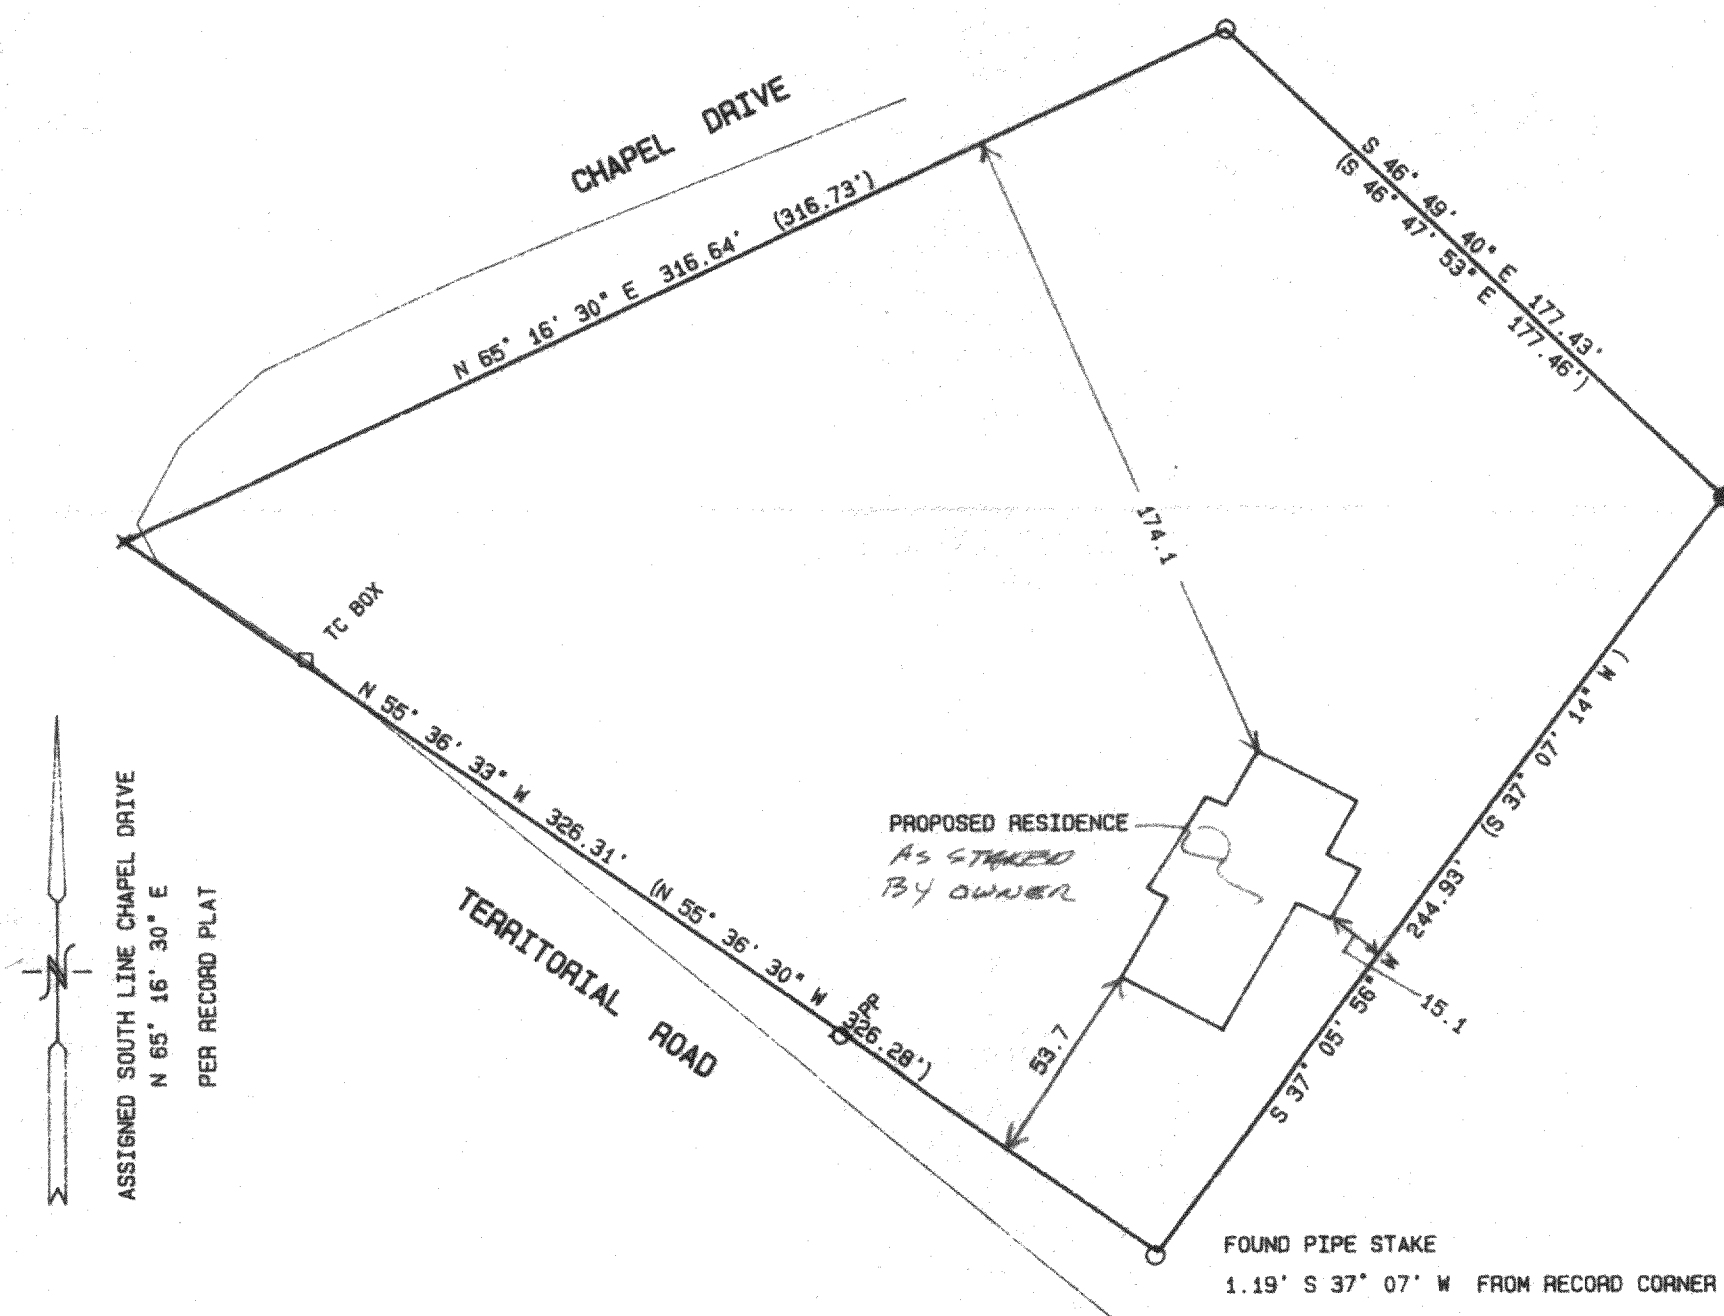


NOTE: COPIES OF THIS MAP TO WHICH THE FOLLOWING CERTIFICATE WILL APPLY ARE BLUE LINE PRINTS SHOWING SURVEYOR'S ORIGINAL SEAL AND SIGNATURE IN BLACK INK. COPIES BY ANY OTHER MEANS MAY HAVE ALTERATIONS WHICH DO NOT REPRESENT THE SURVEYOR'S WORK PRODUCT.

I HEREBY CERTIFY THAT THE ABOVE DESCRIBED PROPERTY HAS BEEN SURVEYED UNDER MY DIRECTION AND THAT THE ABOVE MAP IS A TRUE REPRESENTATION THEREOF AND SHOWS THE SIZE AND LOCATION OF THE PROPERTY AND ITS EXTERIOR BOUNDARIES. THIS SURVEY IS MADE FOR THE USE OF THE PRESENT OWNERS OF THE PROPERTY, AND ALSO THOSE WHO PURCHASE, MORTGAGE, OR GUARANTEE THE TITLE THERETO WITHIN ONE YEAR FROM THE DATE HEREOF.

DATED: 6-24-96

Peter S. Gordon
 PETER S. GORDON R.L.S. 2101

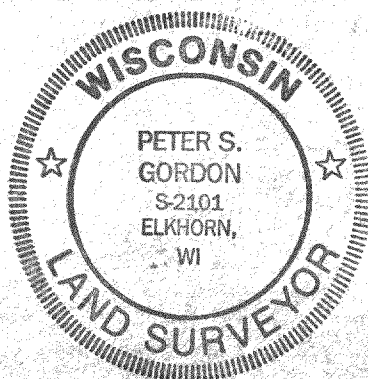

PROJ 4522
 SHEET 1 OF 1

CA-1947-1
 315-531