
ABELL SURVEYING & MAPPING DELAVAN, WISCONSIN 53115

414-728-6737

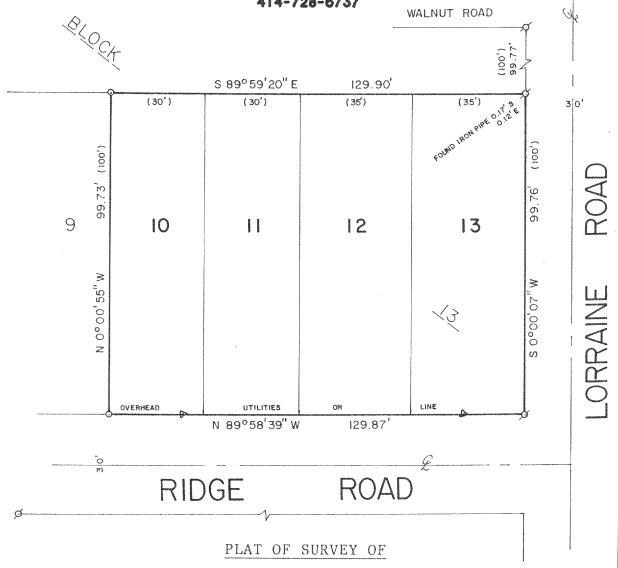

LOTS 10-13, BLOCK 13, SKANSEN'S SWEDISH TRIBUNE NEWS SUBDIVISION, T3N,R15E, WALWORTH COUNTY, WISCONSIN.

ORDERED BY: SANDRA KOSZYCZAREK

W8717 RIDGE ROAD DELAVAN, WI 53115

NOTE: THE BEARING ON THE SOUTH LINE OF WALNUT ROAD IS ASSUMED EAST.





SCALE - 1"=30'

LEGEND

ø - IRON PIPE FOUND

o - IRON ROD SET

Δ - UTILITY POLE

()- RECORDED AS

1 HEREBY CERTIFY THAT I HAVE SURVEYED THE ABOVE DESCRIBED PROPERTY AND THAT THE ABOVE MAP IS A TRUE REPRESENTATION THEREOF AND SHOWS THE SIZE AND LOCATION OF THE PROPERTY. ITS EXTERIOR BOUNDARIES. THE LOCATION OF ALL VISIBLE STRUCTURES AND DIMENSIONS OF ALL PRINCIPAL BUILDINGS THEREON, BOUNDARY FENCES, APPARENT EASEMENTS. ROADWAYS AND VISIBLE ENCROACHMENTS. IF ANY, TO THE BEST OF MY KNOWLEDGE AND BELIEF:

THIS SURVEY IS MADE FOR THE USE OF THE PRESENT OWNERS OF THE PROPERTY, AND ALSO THOSE WHO PURCHASE. MORTGAGE, OR GUARANTEE THE TITLE THERETO WITHIN ONE (1) YEAR FROM DATE HEREON.

David 7. Phill

DAVID F. ABELL WISCONSIN REGISTERED LAND SURVEYOR. S-1596

0s-213 315-551 March 18, 1996

DATE JOB NUMBER - 96022
NOTE: THIS IS NOT A CERTIFIED COPY UNLESS SEALED.