




TELEPHONE (414) 542-5787 FAX (414) 542-7888

SURVEY CERTIFICATE: I have surveyed the above described property and the map shown is a true representation thereof and shows the size and location of the property, its exterior boundaries, the location and dimensions of all visible structures thereon, fences, apparent easements and roadways and visible encroachments if any. This survey is made for the exclusive use of the present owners of the property and also those who purchase, mortgage or guarantee the title thereto within one (1) year from date hereof and as to them I warrant the accuracy of said survey and map.

LANDS

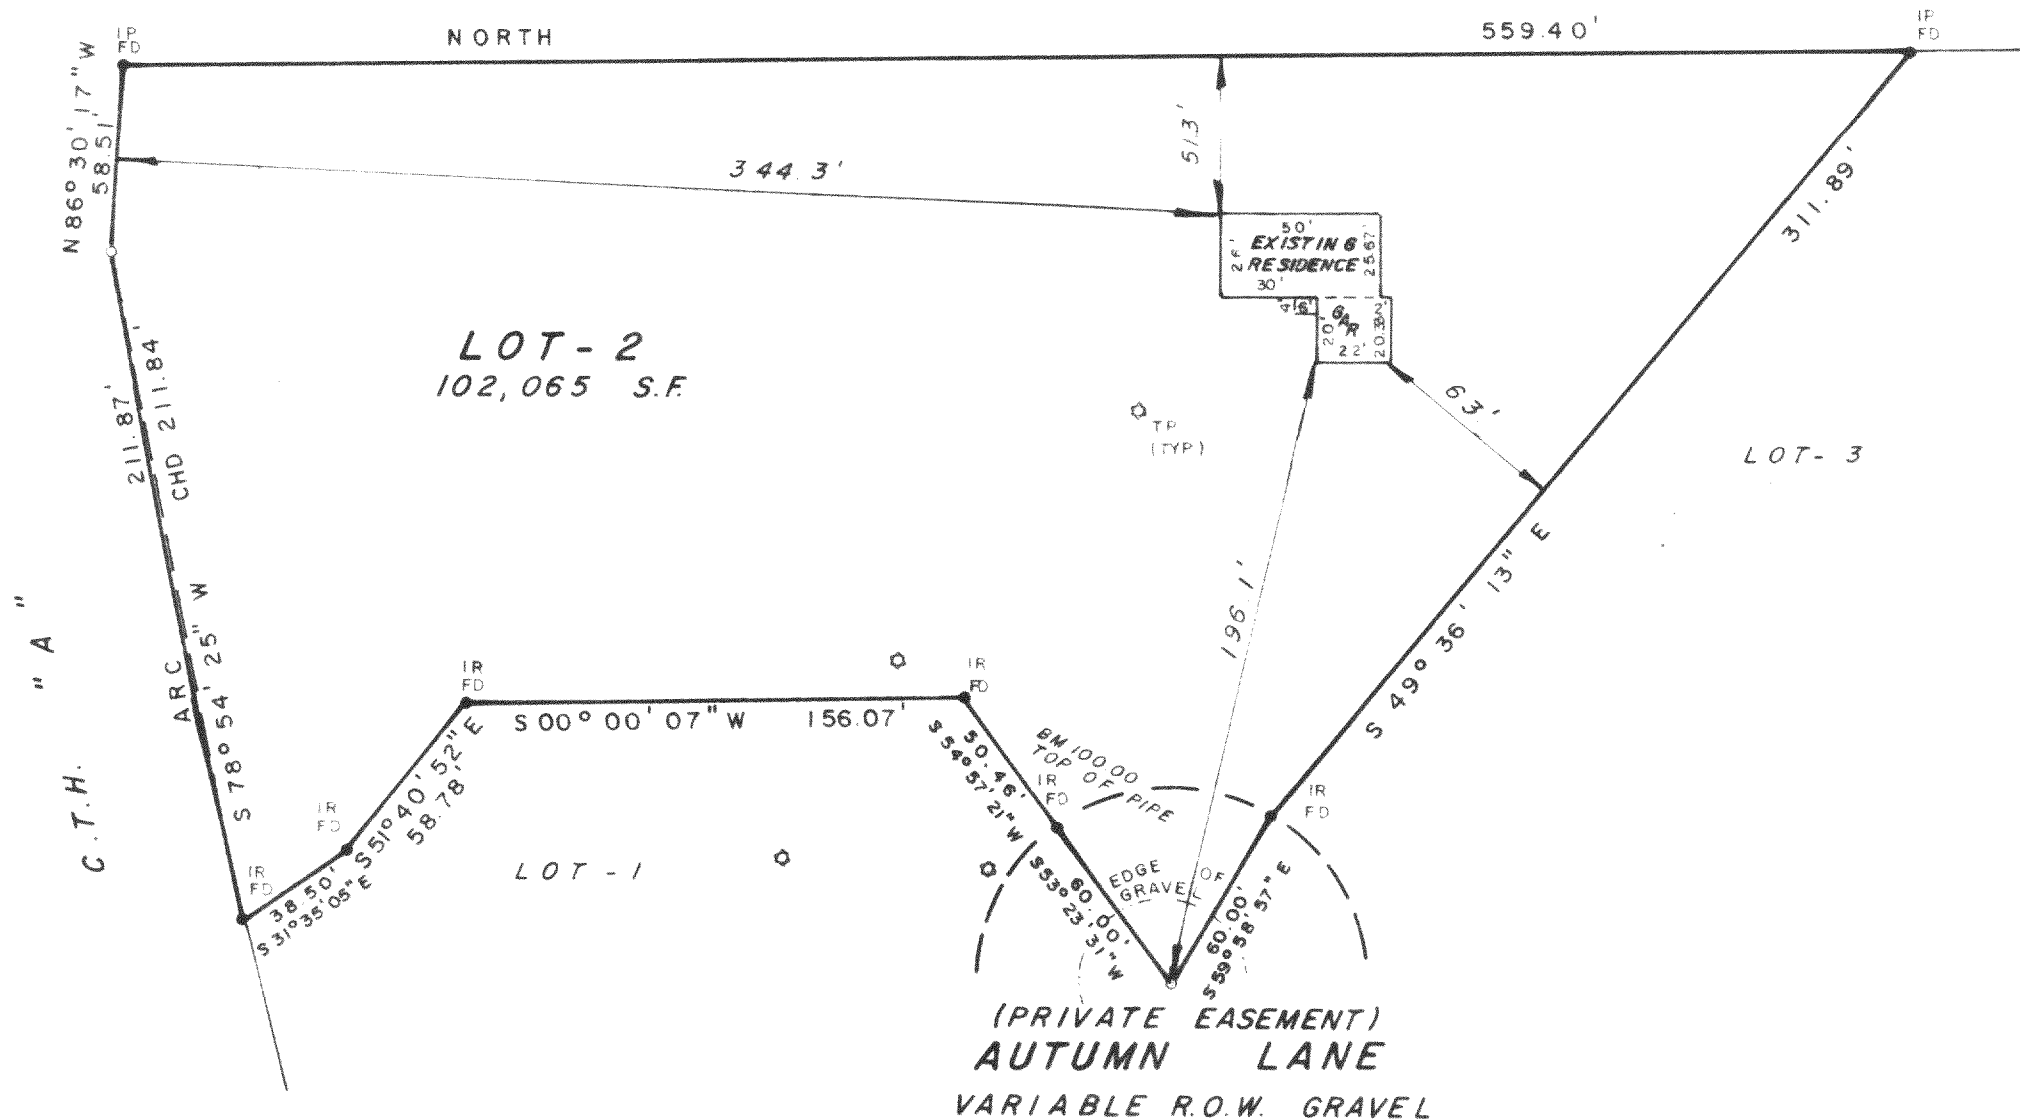

JOHN W. JAHNKE - Wis. Reg. No. S-917

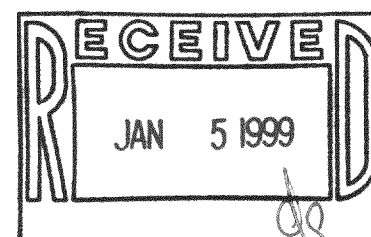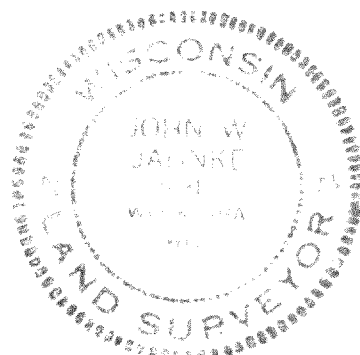

Revised 9/3/98 (Basement survey)
Revised 7/20/98 (Stakeout)

SCALE: 1" = 60'		DATE: MAY 26th, 1998	
DRAWN BY: P. M.		CHECKED BY: J.W.J.	
BOOK NO.: WAL - 10 pg 16		JOB: S/O	
		SHEET	

CA-2706-2 315-644