

ABERNATHY and ASSOCIATES

Kenneth B. Abernathy Jr.

Wisconsin Registered Land Surveyor S-1594

Rt. 3, Box 273
Elkhorn, Wisconsin 53121
Phone: (414) 723-4260 (office)
(414) 723-7209 (FAX)

PLAT OF SURVEY

LOT 18 OF BLOCK 16 OF SKANSEN'S
SWEDISH TRIBUNE NEWS SUBDIVISION,
LOCATED IN SECTION 9, TOWN 3
NORTH, RANGE 15 EAST, WALWORTH
COUNTY, WISCONSIN.

OWNER: ADA LYNN
N 6589 CEDAR RD.
ELKHORN, WI. 53121


ORDERED BY: MARVIN SCHOEMACKER

SPRUCE ROAD 30' WIDE

FOREST ROAD 30' WIDE

EDGE OF BLACKTOP ROADWAY



SCALE 1" = 20 FEET

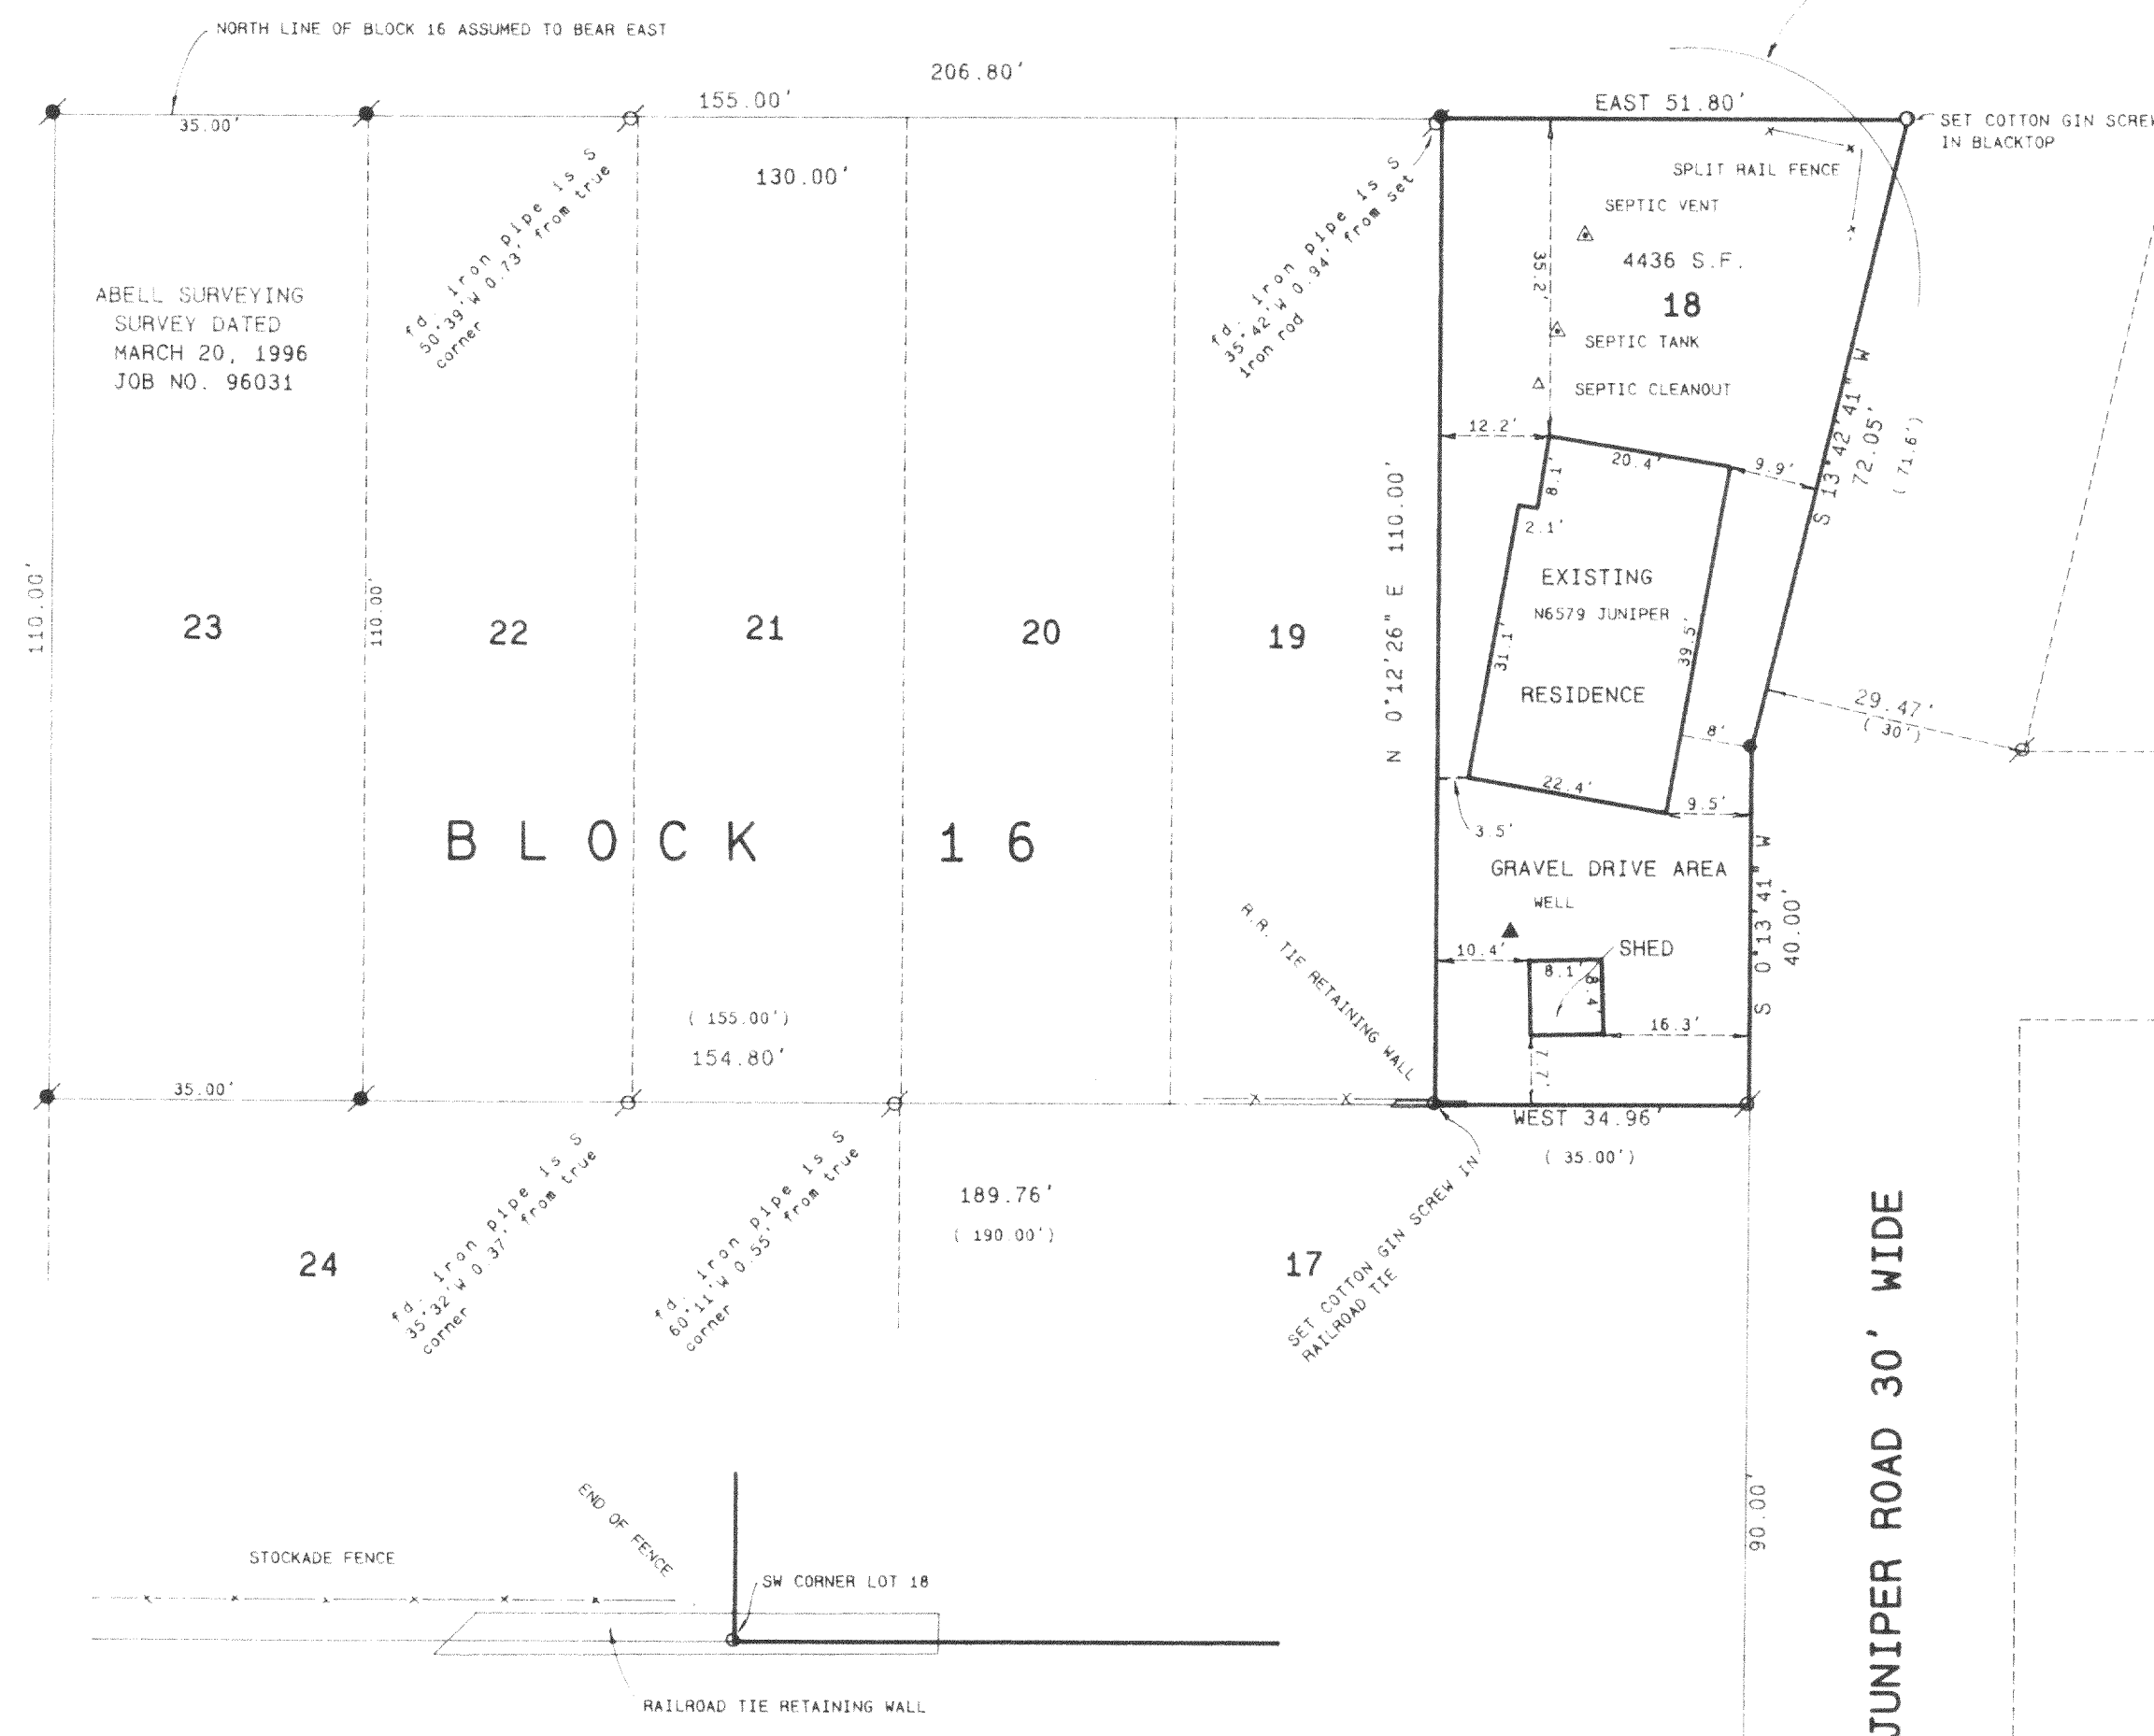

Legend

- FOUND IRON PIPE
- FOUND IRON ROD
- FOUND BRASS CAPPED MONUMENT
- FOUND CONCRETE MONUMENT
- CHISEL CUT IN CONCRETE
- SET IRON ROD, 24" LONG, WEIGHING 1.5 LBS. LINEAL FT., 1/4" DIA.
- SET IRON ROD, 30" LONG, WEIGHING 4.5 LBS. LINEAL FT., 1/2" DIA.
- RECORDED AS DIMENSION
- EXISTING FENCE

SCALE: 1" = 20 FEET

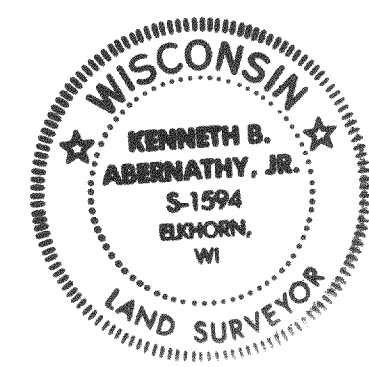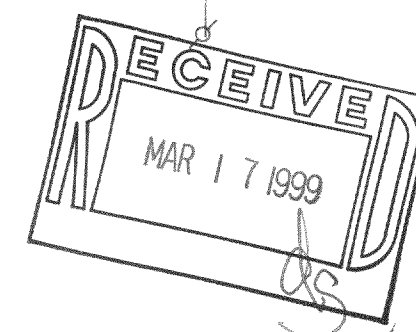

"I hereby certify that the above described property has been surveyed by me or under my direction and that the above map is a true representation thereof and shows the size and location of the property, its exterior boundaries, the location of all visible structures and dimensions of all principal buildings thereon, boundary fences, apparent easements, roadways and visible encroachments, if any."

"This survey is made for the use of the present owners of the property and also those who purchase, mortgage, or guarantee the title thereto within one year from date hereof."

Kenneth B. Abernathy, Jr.

KENNETH B. ABERNATHY, JR.
WISCONSIN REGISTERED LAND SURVEYOR,
S-1594

Date: OCTOBER 26, 1998 Job No. 98.1005

CS-267 315-652