


TERRITORIAL ROAD

ABELL
SURVEYING & MAPPING


1140 SEQUOIA STREET • DELAVAN, WISCONSIN 53115
414-728-6737

NOTE: BEARINGS ARE REFERENCED TO CERTIFIED
SURVEY MAP NO. 2114.

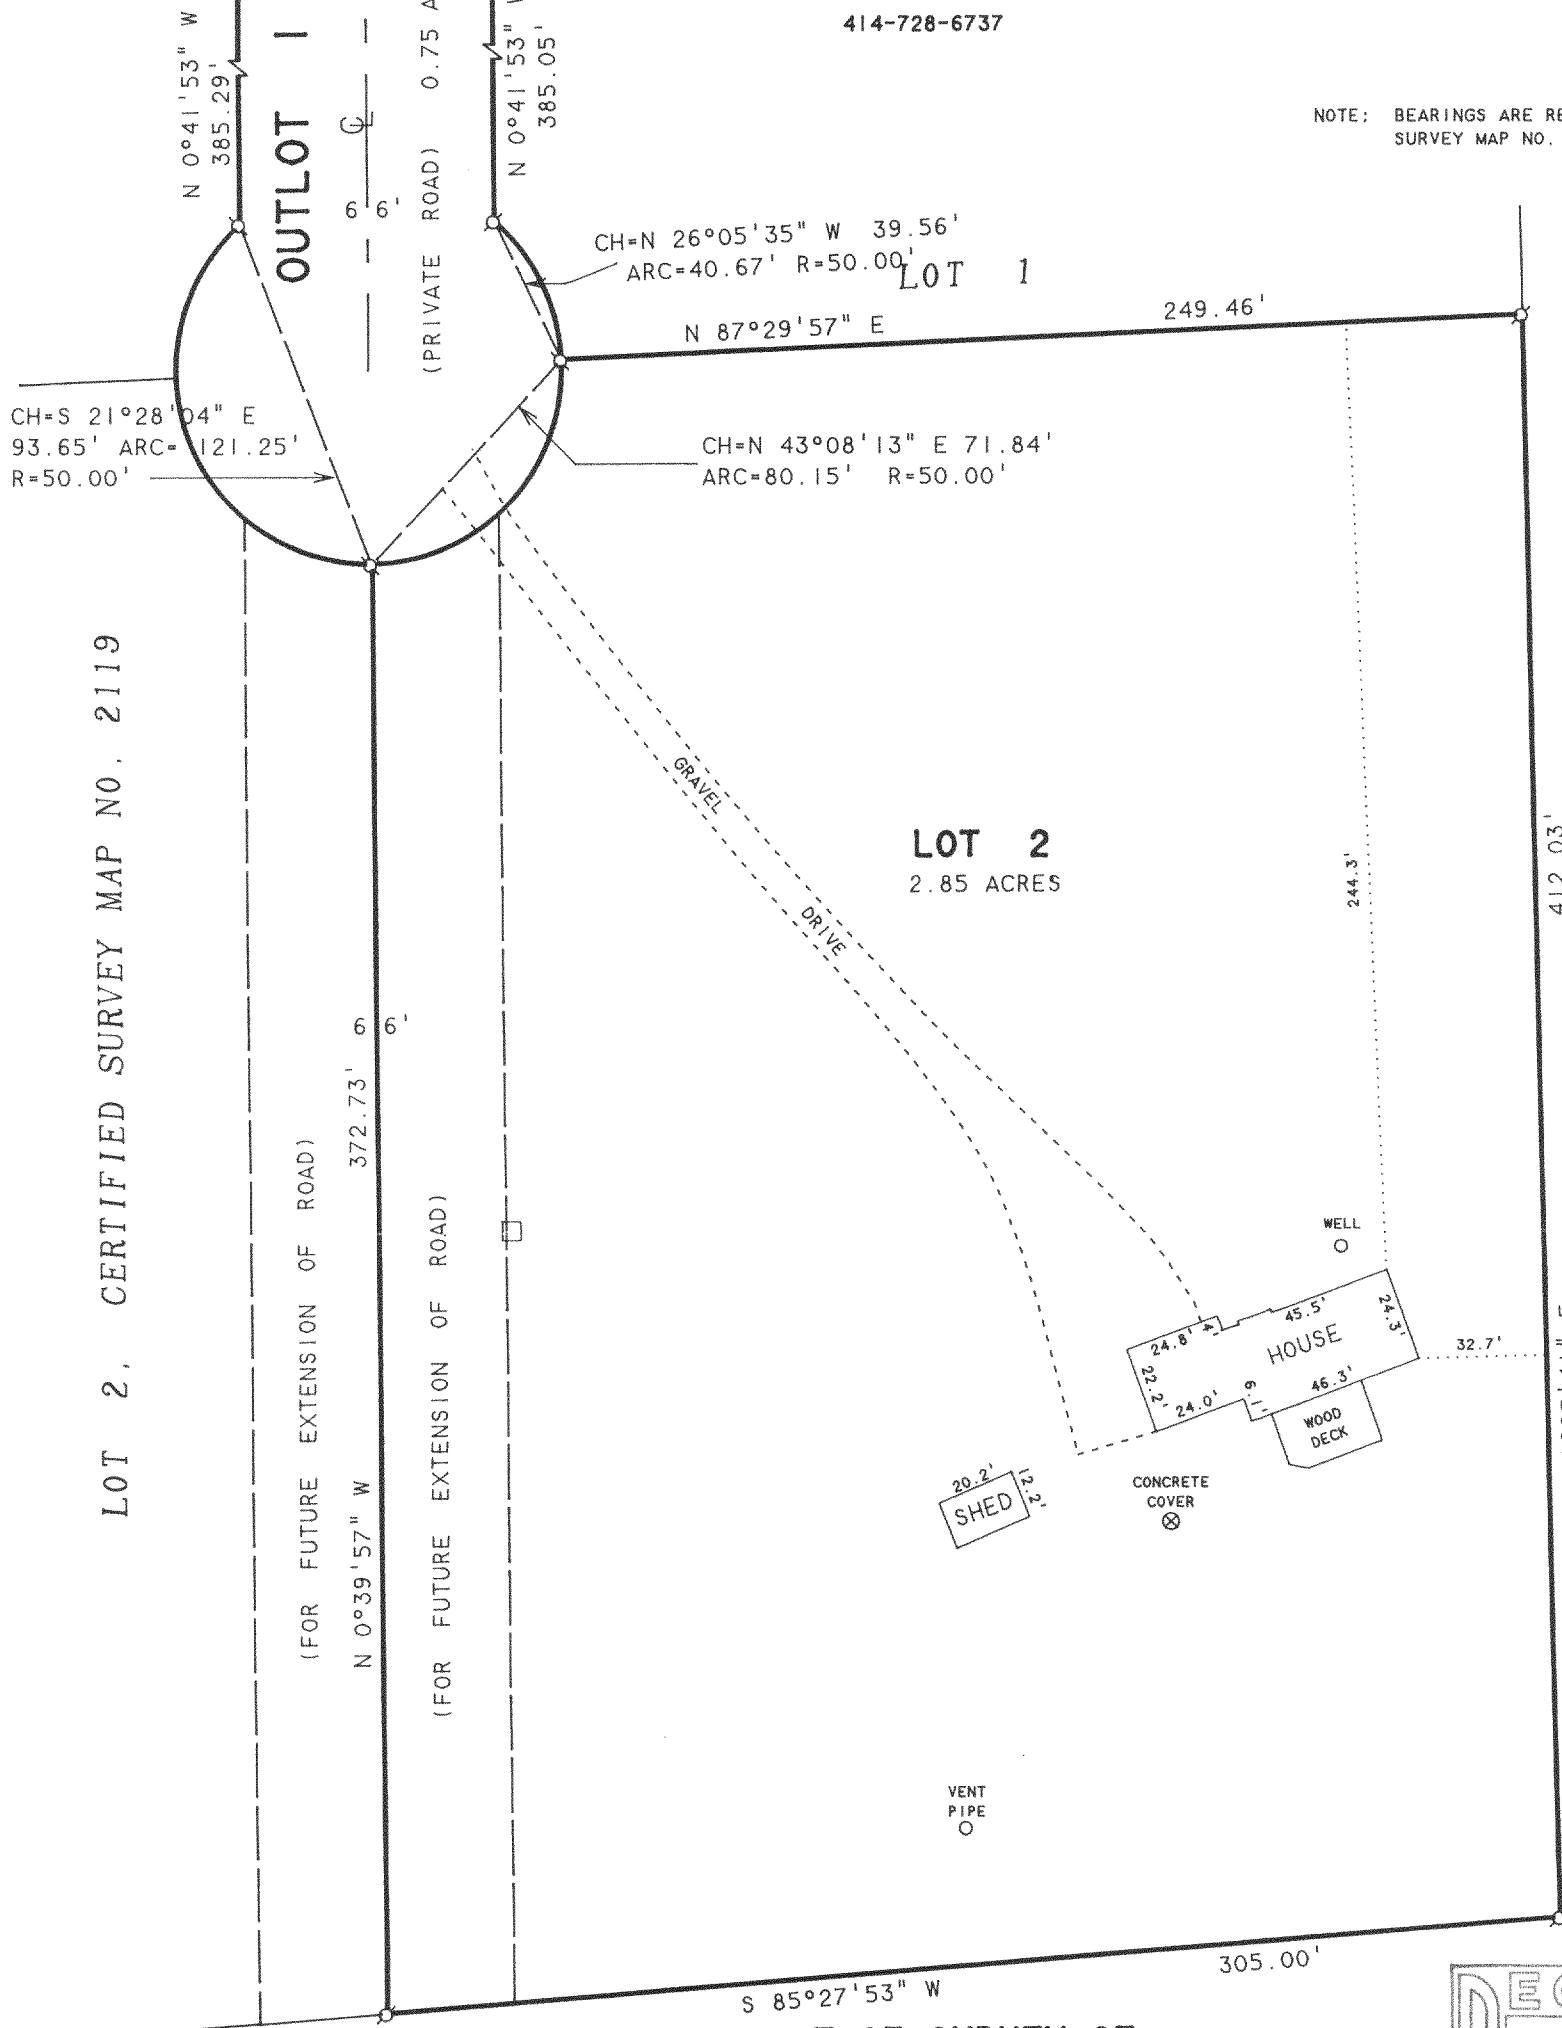

ORDERED BY: WHISPERING OAKS REALTY
P.O. BOX 16
ELKHORN, WI 53121

PLAT OF SURVEY OF
LOT 2 AND 1/2 INTEREST IN OUTLOT 1 OF CERTIFIED SURVEY
MAP NO. 2114, LOCATED IN THE NORTHWEST 1/4 OF THE
NORTHEAST 1/4 OF SECTION 11, T3N, R15E, WALWORTH COUNTY,
WISCONSIN.

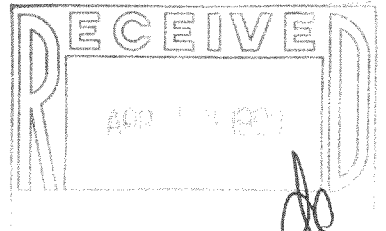

N



SCALE 1"=50'

LEGEND

- - IRON PIPE FOUND
- - UTILITY PED.
- () - RECORDED AS

I HEREBY CERTIFY THAT I HAVE SURVEYED THE ABOVE DESCRIBED PROPERTY AND THAT THE
ABOVE MAP IS A TRUE REPRESENTATION THEREOF AND SHOWS THE SIZE AND LOCATION OF
THE PROPERTY, ITS EXTERIOR BOUNDARIES, THE LOCATION OF ALL VISIBLE STRUCTURES
AND DIMENSIONS OF ALL PRINCIPAL BUILDINGS THEREON, BOUNDARY FENCES, APPARENT
EASEMENTS, ROADWAYS AND VISIBLE ENCROACHMENTS, IF ANY, TO THE BEST OF MY
KNOWLEDGE AND BELIEF.

THIS SURVEY IS MADE FOR THE USE OF THE PRESENT OWNERS OF THE PROPERTY, AND ALSO
THOSE WHO PURCHASE, MORTGAGE, OR GUARANTEE THE TITLE THERETO WITHIN ONE (1) YEAR
FROM DATE HEREON.

David F. Abell

DAVID F. ABELL
WISCONSIN REGISTERED LAND SURVEYOR, S-1596

March 3, 1999

REVISED: 3/5/99

DATE JOB NUMBER - 92006A
NOTE: THIS IS NOT A CERTIFIED COPY UNLESS SEALED.


CA-2114-2

315-657

ABELL
SURVEYING & MAPPING


1140 SEQUOIA STREET • DELAVAN, WISCONSIN 53115
414-728-6737

NOTE: BEARINGS ARE REFERENCED TO CERTIFIED
SURVEY MAP NO. 2114.

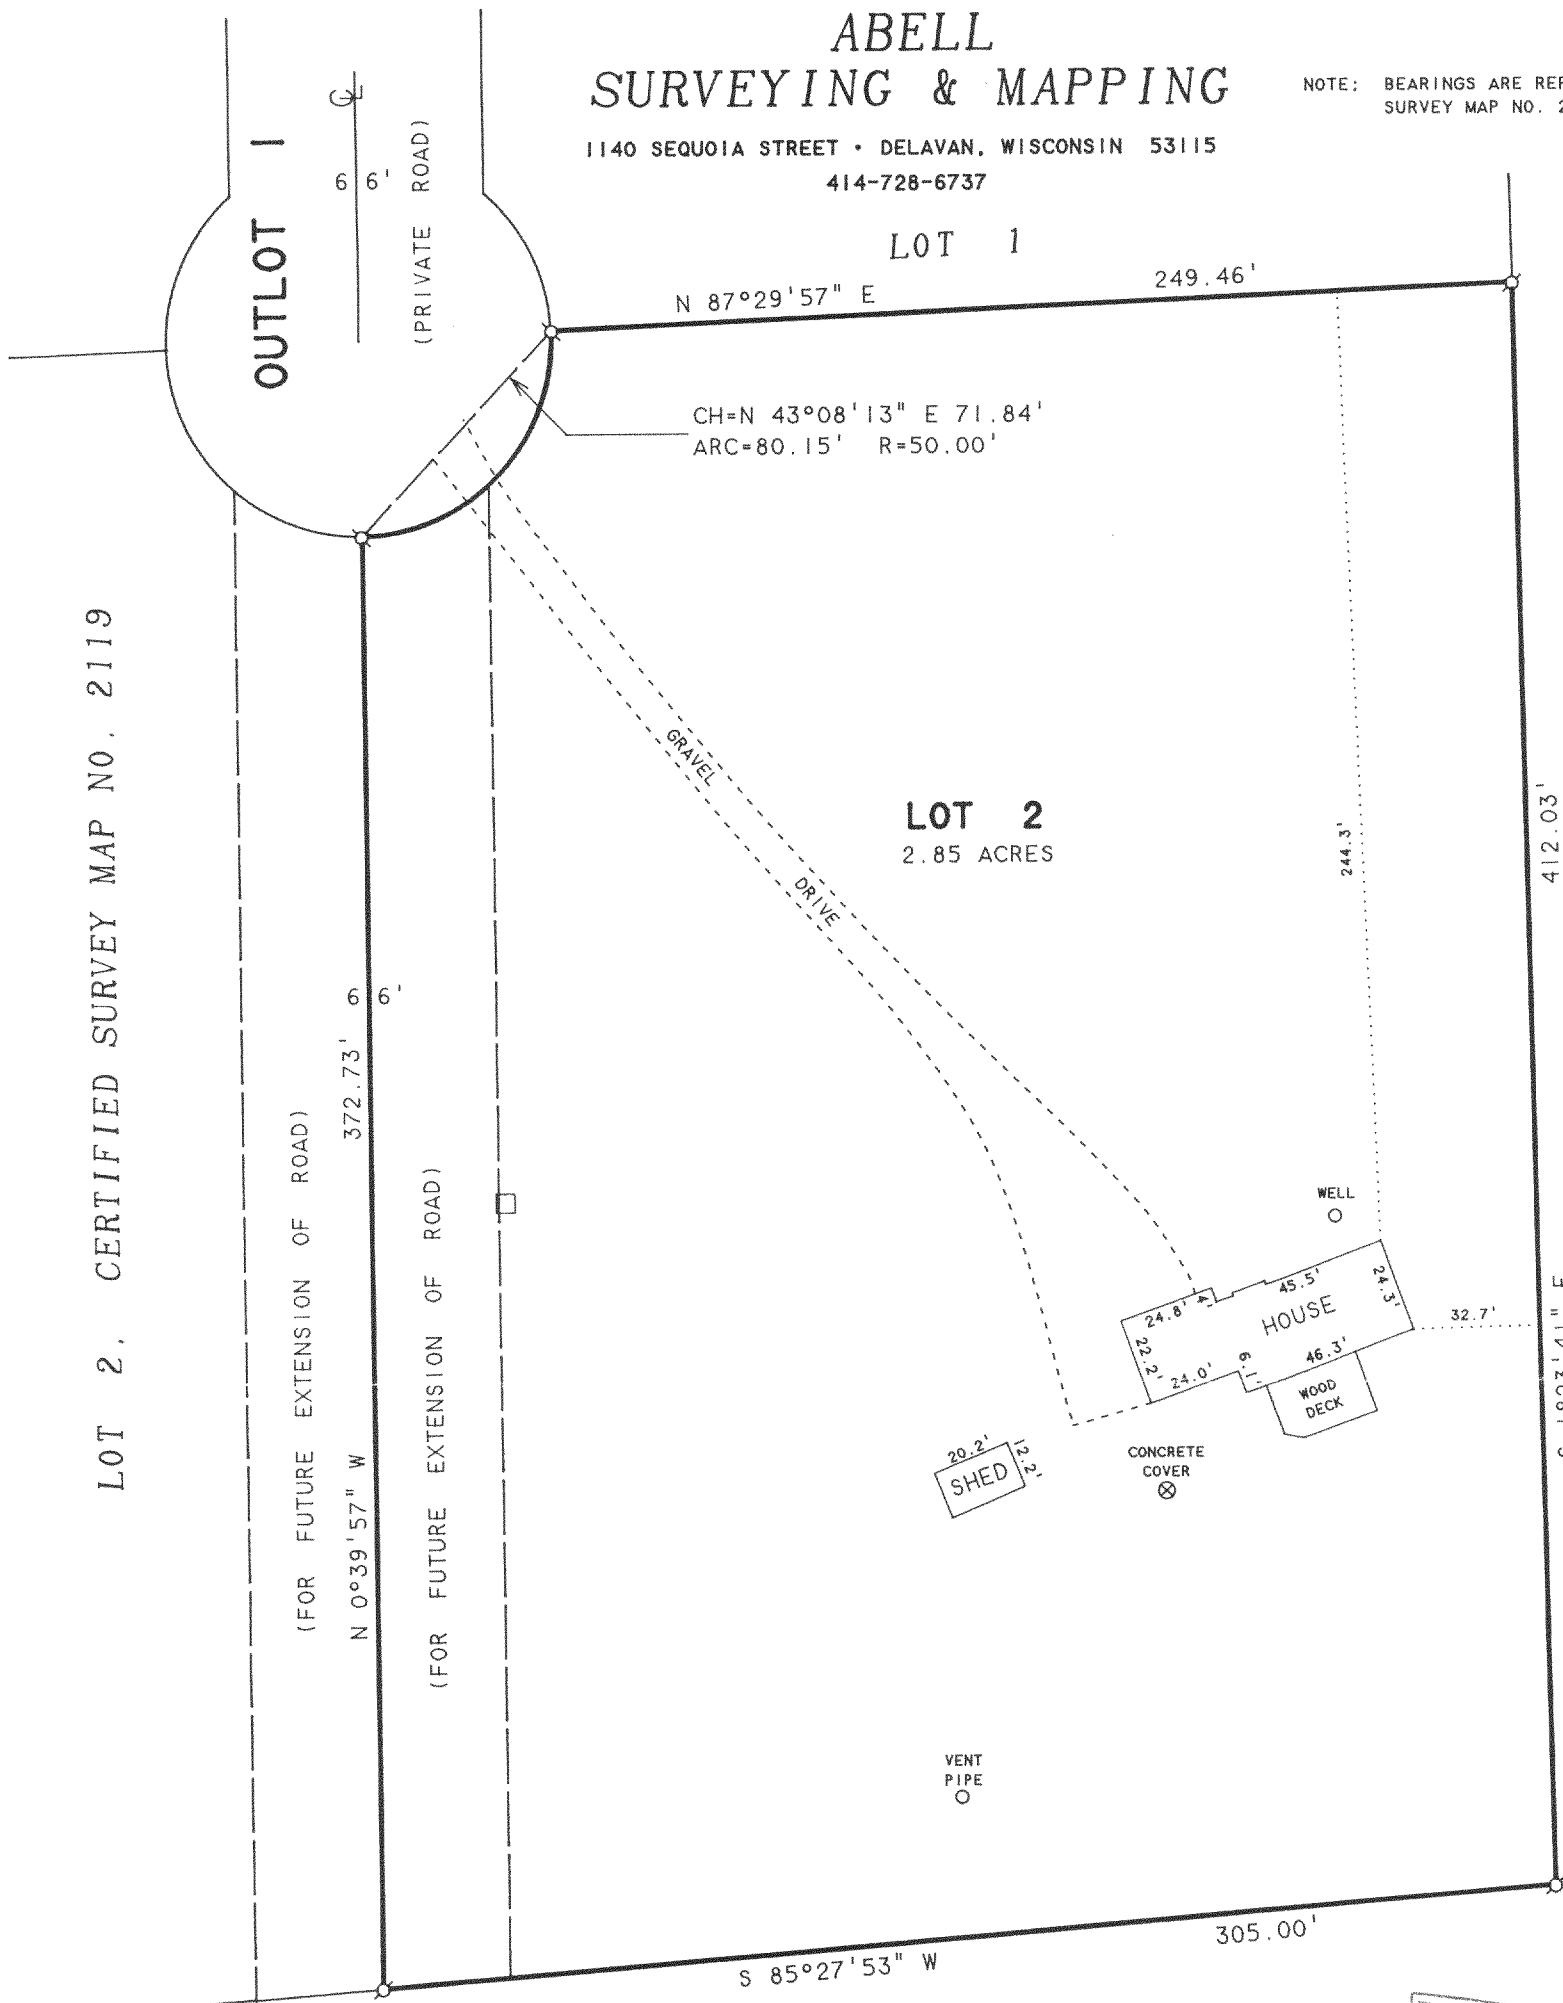

ORDERED BY: WHISPERING OAKS REALTY
P.O. BOX 16
ELKHORN, WI 53121

LOT 2, CERTIFIED SURVEY MAP NO. 2114, LOCATED
IN THE NORTHWEST 1/4 OF THE NORTHEAST 1/4 OF
SECTION 11, T3N, R15E, WALWORTH COUNTY, WISCONSIN.

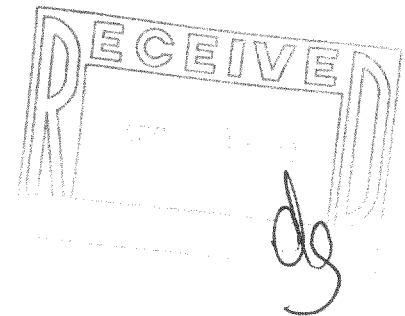

N



SCALE 1"=50'

LEGEND

- - IRON PIPE FOUND
- - UTILITY PED.
- () - RECORDED AS

I HEREBY CERTIFY THAT I HAVE SURVEYED THE ABOVE DESCRIBED PROPERTY AND THAT THE ABOVE MAP IS A TRUE REPRESENTATION THEREOF AND SHOWS THE SIZE AND LOCATION OF THE PROPERTY, ITS EXTERIOR BOUNDARIES, THE LOCATION OF ALL VISIBLE STRUCTURES AND DIMENSIONS OF ALL PRINCIPAL BUILDINGS THEREON, BOUNDARY FENCES, APPARENT EASEMENTS, ROADWAYS AND VISIBLE ENCROACHMENTS, IF ANY, TO THE BEST OF MY KNOWLEDGE AND BELIEF.

THIS SURVEY IS MADE FOR THE USE OF THE PRESENT OWNERS OF THE PROPERTY, AND ALSO THOSE WHO PURCHASE, MORTGAGE, OR GUARANTEE THE TITLE THERETO WITHIN ONE (1) YEAR FROM DATE HEREON.

David F. Abell

DAVID F. ABELL
WISCONSIN REGISTERED LAND SURVEYOR, S-1596

March 3, 1999

DATE: MARCH 3, 1999 JOB NUMBER - 92006A
NOTE: THIS IS NOT A CERTIFIED COPY UNLESS SEALED.