


PLAT OF SURVEY OF

LOT 12, OAK KNOLL, LOCATED IN THE TOWN OF RICHMOND & THE TOWN OF WHITEWATER,
WALWORTH COUNTY, WISCONSIN.

State of Wisconsin s.s.
County of Walworth

I hereby certify that I have surveyed the property described above according to official records and that the plat hereon drawn correctly represents said survey and its location, that no encroachments appear from said survey except as noted hereon.

Given under my hand and seal this 16th day of July, 1971, A.D. Cambridge, Wisconsin.

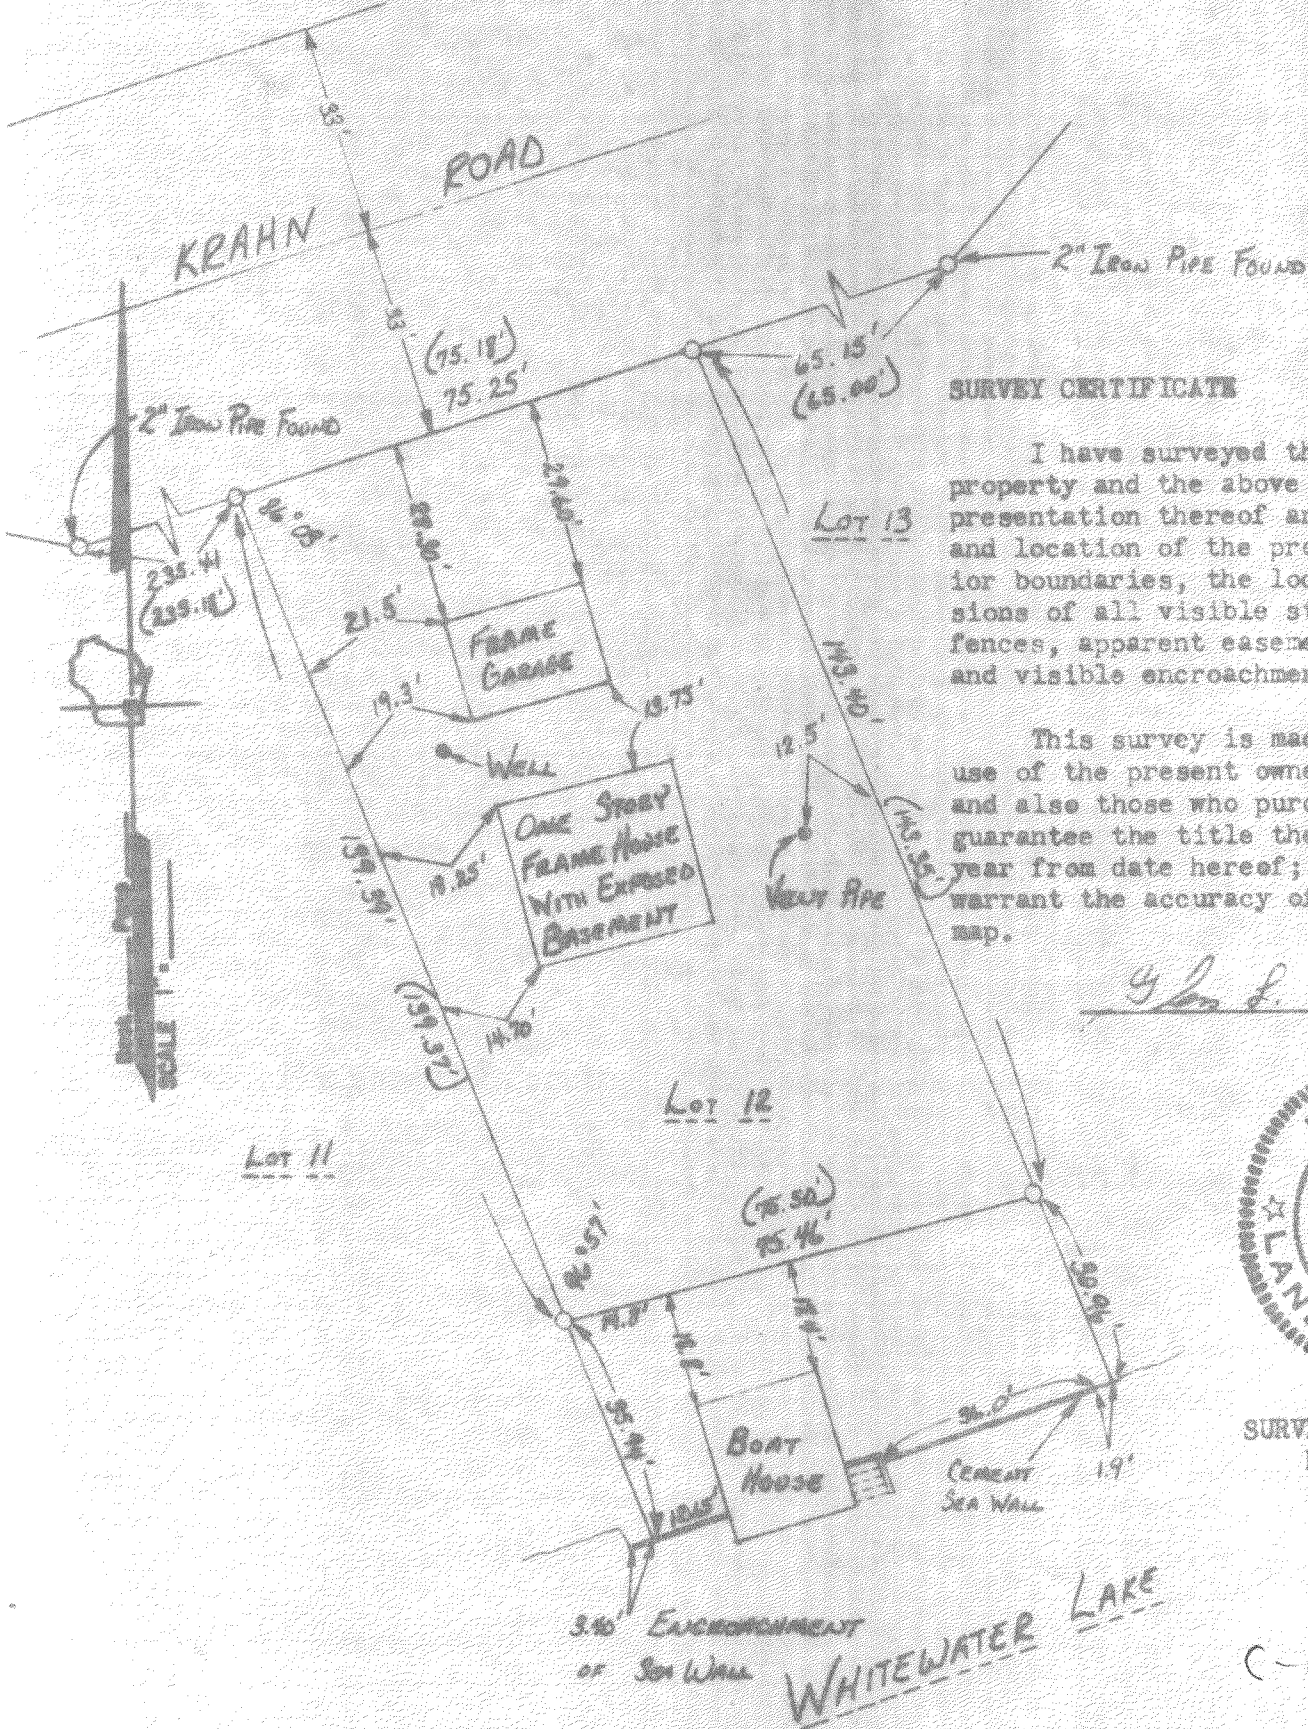

SURVEY CERTIFICATE

I have surveyed the above-described property and the above map is a true representation thereof and shows the size and location of the property, its exterior boundaries, the location and dimensions of all visible structures thereon, fences, apparent easements and roadways and visible encroachments, if any.

This survey is made for the exclusive use of the present owners of the property, and also those who purchase, mortgage, or guarantee the title thereto within one (1) year from date hereof; and as to them I warrant the accuracy of said survey and map.

Glen L. Northrop



SURVEYED FOR:
Mr. Matt Schmidt
Whitewater, Wisc.

C-OK-12

- Existing 1" iron pipe found, unless otherwise indicated
- () Recorded distance



COK-12