

1140 SEQUOIA STREET • DELAVAN, WISCONSIN 53115  
414-728-6737

ORDERED BY: RE/MAX - HEARTLAND REALTY  
239 E. MILWAUKEE STREET  
WHITEWATER, WI 53190




SCALE 1" = 20'

### LEGEND

- -IRON PIPE FOUND
- -CONCRETE MONUMENT FOUND
- ⌒ -POSEY PIN FOUND
- -POSEY PIN FOUND, 1" DIA.  
IRON PIPE SET
- CS -CONCRETE STOOP
- △ -UTILITY POLE
- -OVERHEAD UTILITY LINES
- -GUY WIRE
- -UTILITY PED.
- ( ) -RECORDED AS

NOTE: BEARINGS ARE REFERENCED TO THE  
RECORDED SUBDIVISION PLAT.

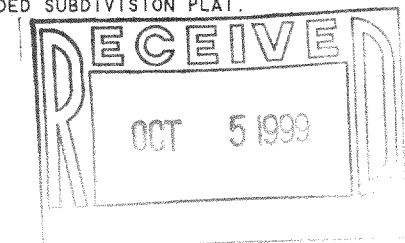

I HEREBY CERTIFY THAT I HAVE SURVEYED THE ABOVE DESCRIBED PROPERTY AND THAT THE ABOVE MAP IS A TRUE REPRESENTATION THEREOF AND SHOWS THE SIZE AND LOCATION OF THE PROPERTY, ITS EXTERIOR BOUNDARIES, THE LOCATION OF ALL VISIBLE STRUCTURES AND DIMENSIONS OF ALL PRINCIPAL BUILDINGS THEREON, BOUNDARY FENCES, APPARENT EASEMENTS, ROADWAYS AND VISIBLE ENCROACHMENTS, IF ANY, TO THE BEST OF MY KNOWLEDGE AND BELIEF.

THIS SURVEY IS MADE FOR THE USE OF THE PRESENT OWNERS OF THE PROPERTY, AND ALSO THOSE WHO PURCHASE, MORTGAGE, OR GUARANTEE THE TITLE THERETO WITHIN ONE (1) YEAR FROM DATE HEREON.

DAVID F. ABELL  
WISCONSIN REGISTERED LAND SURVEYOR. S-1596

July 30, 1999

DATE \_\_\_\_\_ JOB NUMBER - 99125  
NOTE: THIS IS NOT A CERTIFIED COPY UNLESS SEALED.

CFB-5

315-681