


DUNHAM SURVEYING, S.C.
SURVEYING & SUBDIVIDING
DELAVER, WISCONSIN 53115

ETHELYN

DRIVE

MILWAUKEE

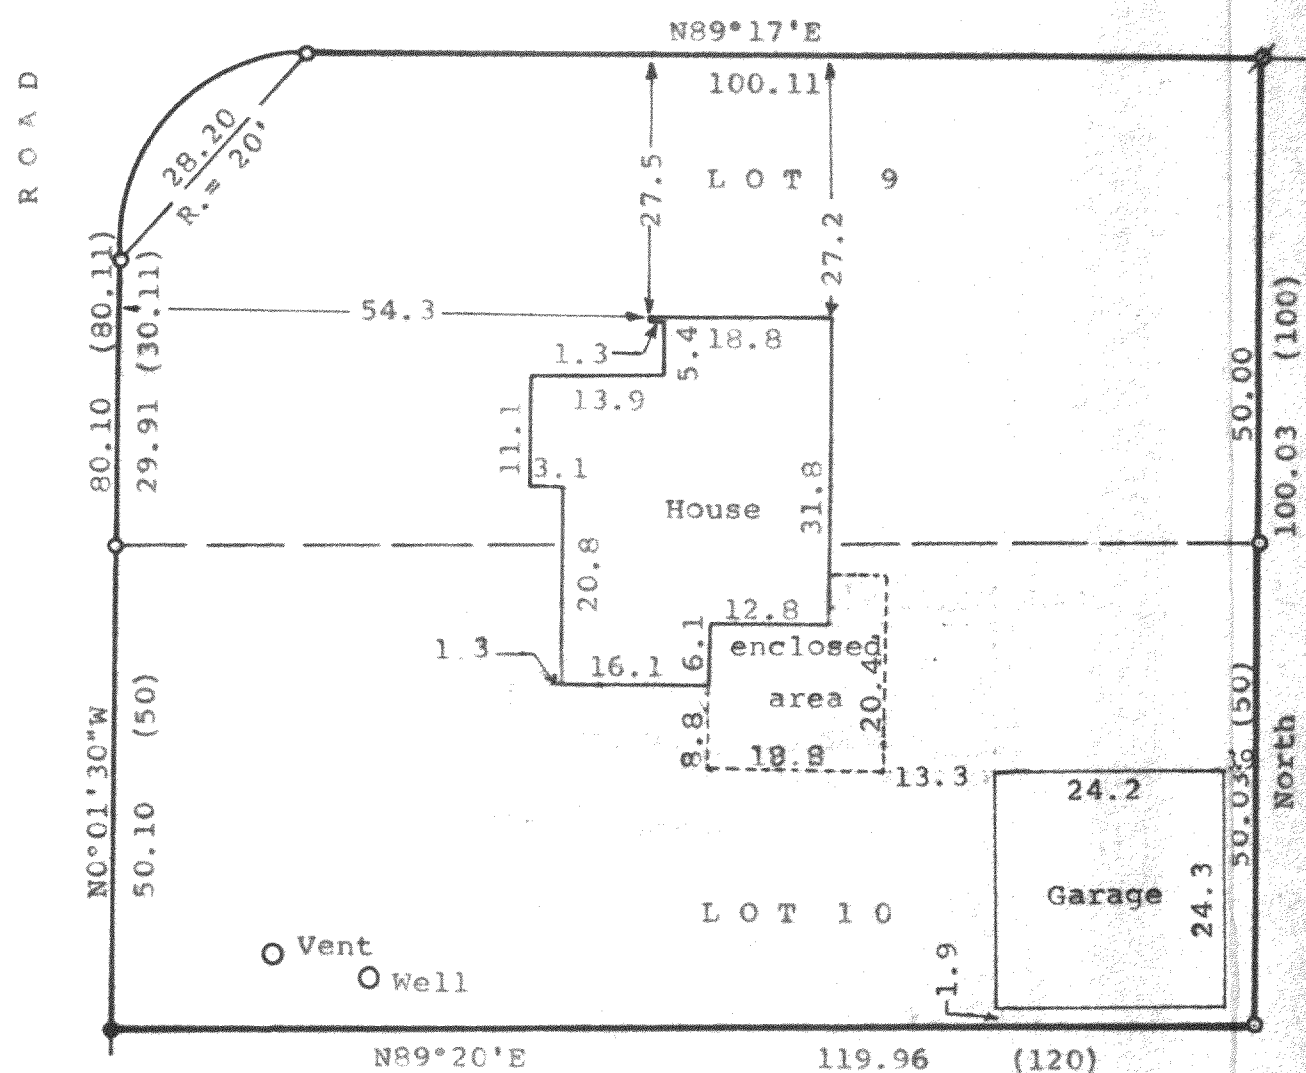

Scale - 1" = 20'

● = 1" Dia. Iron Rod Found

○ = 5/8" Dia. Iron Rod Found

⊗ = 5/8" Dia. Iron Rod Found Bent

and reset with 3/4"x24" Iron Pipe

(000) = Recorded Distance

Bearings are based on the East line of property surveyed, assumed bearing of North.

Survey Ordered By:

Century 21

Skandia Realty

312 S. 7th Street

Delavan, WI 53115

Updating and recertification ordered by:

Century 21, Skandia Realty

822 East Geneva Street

Delavan, WI 53115

STATE OF WISCONSIN) SS
COUNTY OF WALWORTH)

I, George T. Dunham, Surveyor, certify that I have surveyed the property described as follows,

Lots 9 and 10, Block "K" located in Crystal Bowl, a subdivision located in Sections 12 and 13, T3N, R15E, Walworth County, Wisconsin, and that the map shown hereon is a correct representation thereof and shows the size and location of the property, its exterior boundaries, the location of all visible structures and dimensions of all principal buildings thereon, boundary fences, apparent easements, roadways and visible encroachments, if any, and that I have surveyed the property hereon described according to the official records, to the best of my knowledge and belief.

March 15, 1988.

Updated and recertified to
January 22, 2002

George T. Dunham
George T. Dunham, Surveyor

