

1140 SEQUOIA STREET • DELAVAN, WISCONSIN 53115
262-728-6737




SCALE 1" = 20'

LEGEND

-  - IRON PIPE FOUND
 - IRON ROD FOUND
 - UTILITY POLE
 - OVERHEAD UTILITY LINES
 - WIRE FENCE
 - WOOD RAIL FENCE
 - GUY WIRE
 - RECORDED AS


PLAT OF SURVEY OF

LOTS 1-7, BLOCK 5, SKANSENS SWEDISH
TRIBUNE NEWS SUBDIVISION, LOCATED IN
T3N, R15E, WALWORTH COUNTY, WISCONSIN.

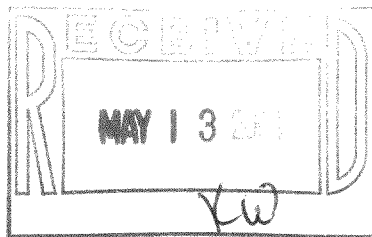

REVISED DATE: FEBRUARY 23, 2004
REVISED TO SHOW NEW HOUSE AND GARAGE
FOUNDATION.

ORDERED BY: LYLE BLAEDOW
N6520 LORRAINE ROAD
DELAVAN, WI 53115

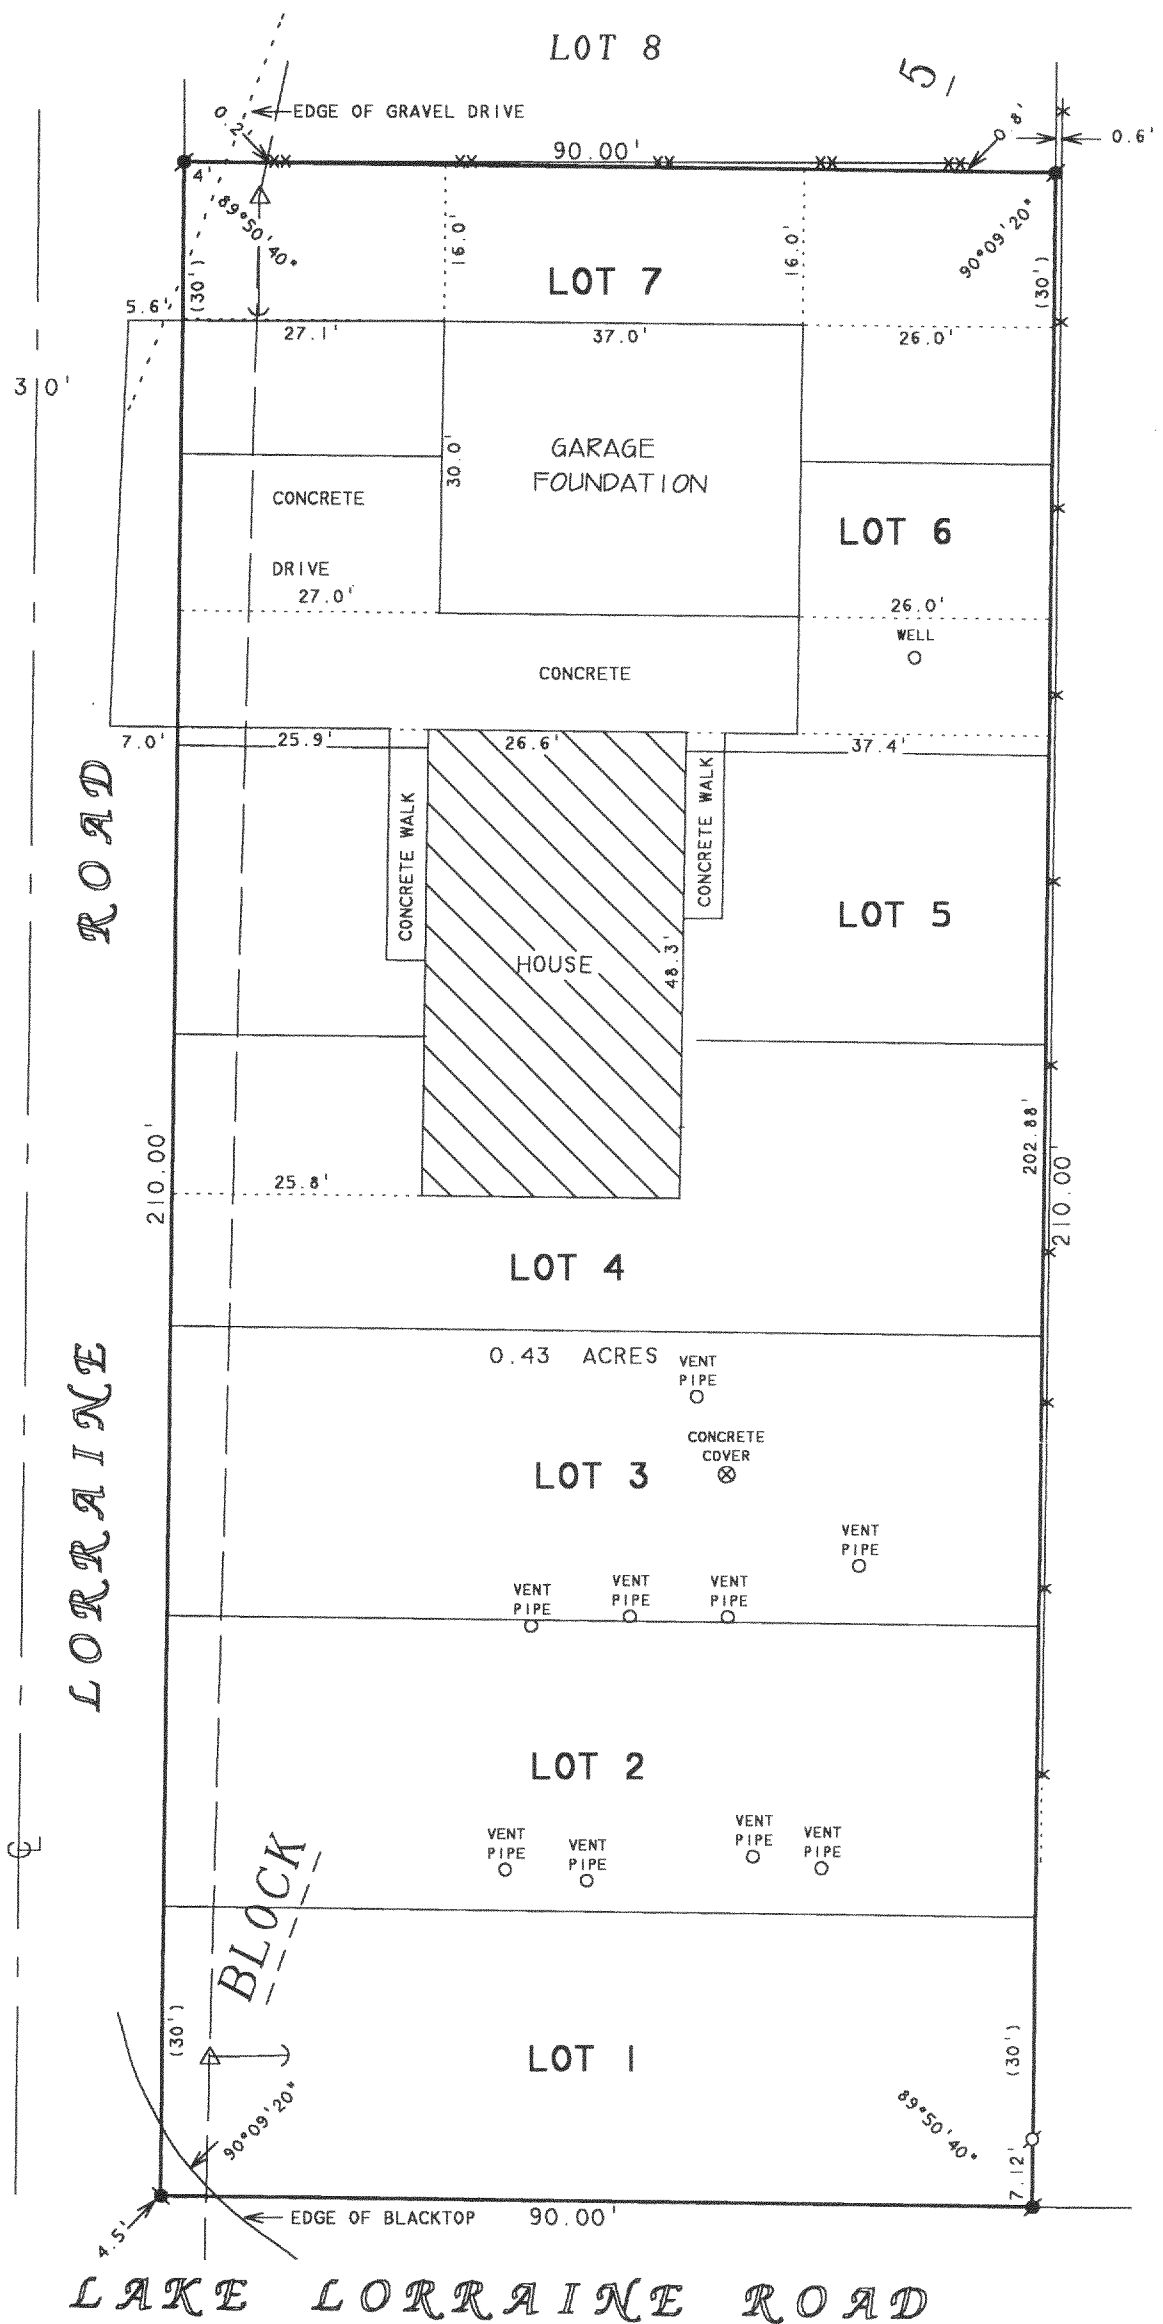

I HEREBY CERTIFY THAT I HAVE SURVEYED THE ABOVE DESCRIBED PROPERTY AND THAT THE ABOVE MAP IS A TRUE REPRESENTATION THEREOF AND SHOWS THE SIZE AND LOCATION OF THE PROPERTY, ITS EXTERIOR BOUNDARIES, THE LOCATION OF ALL VISIBLE STRUCTURES AND DIMENSIONS OF ALL PRINCIPAL BUILDINGS THEREON, BOUNDARY FENCES, APPARENT EASEMENTS, ROADWAYS AND VISIBLE ENCROACHMENTS, IF ANY, TO THE BEST OF MY KNOWLEDGE AND BELIEF.

THIS SURVEY IS MADE FOR THE USE OF THE PRESENT OWNERS OF THE PROPERTY, AND ALSO THOSE WHO PURCHASE. MORTGAGE, OR GUARANTEE THE TITLE THERETO WITHIN ONE (1) YEAR FROM DATE HEREON.

DAVID F. ABELL
WISCONSIN REGISTERED LAND SURVEYOR, S-1596

June 23, 2003

DATE _____ JOB NUMBER - 95067B
NOTE: THIS IS NOT A CERTIFIED COPY UNLESS SEALED.

CS 00080

315-8560