

ABELL SURVEYING & MAPPING

1140 SEQUOIA STREET • DELAVAN, WISCONSIN 53115
262-728-6737

NOTE: BEARINGS ARE REFERENCED TO THE
RECORDED SUBDIVISION PLAT.


N



SCALE 1"=20'

LEGEND

⊙ - IRON PIPE FOUND
CP - CONCRETE PORCH
() - RECORDED AS

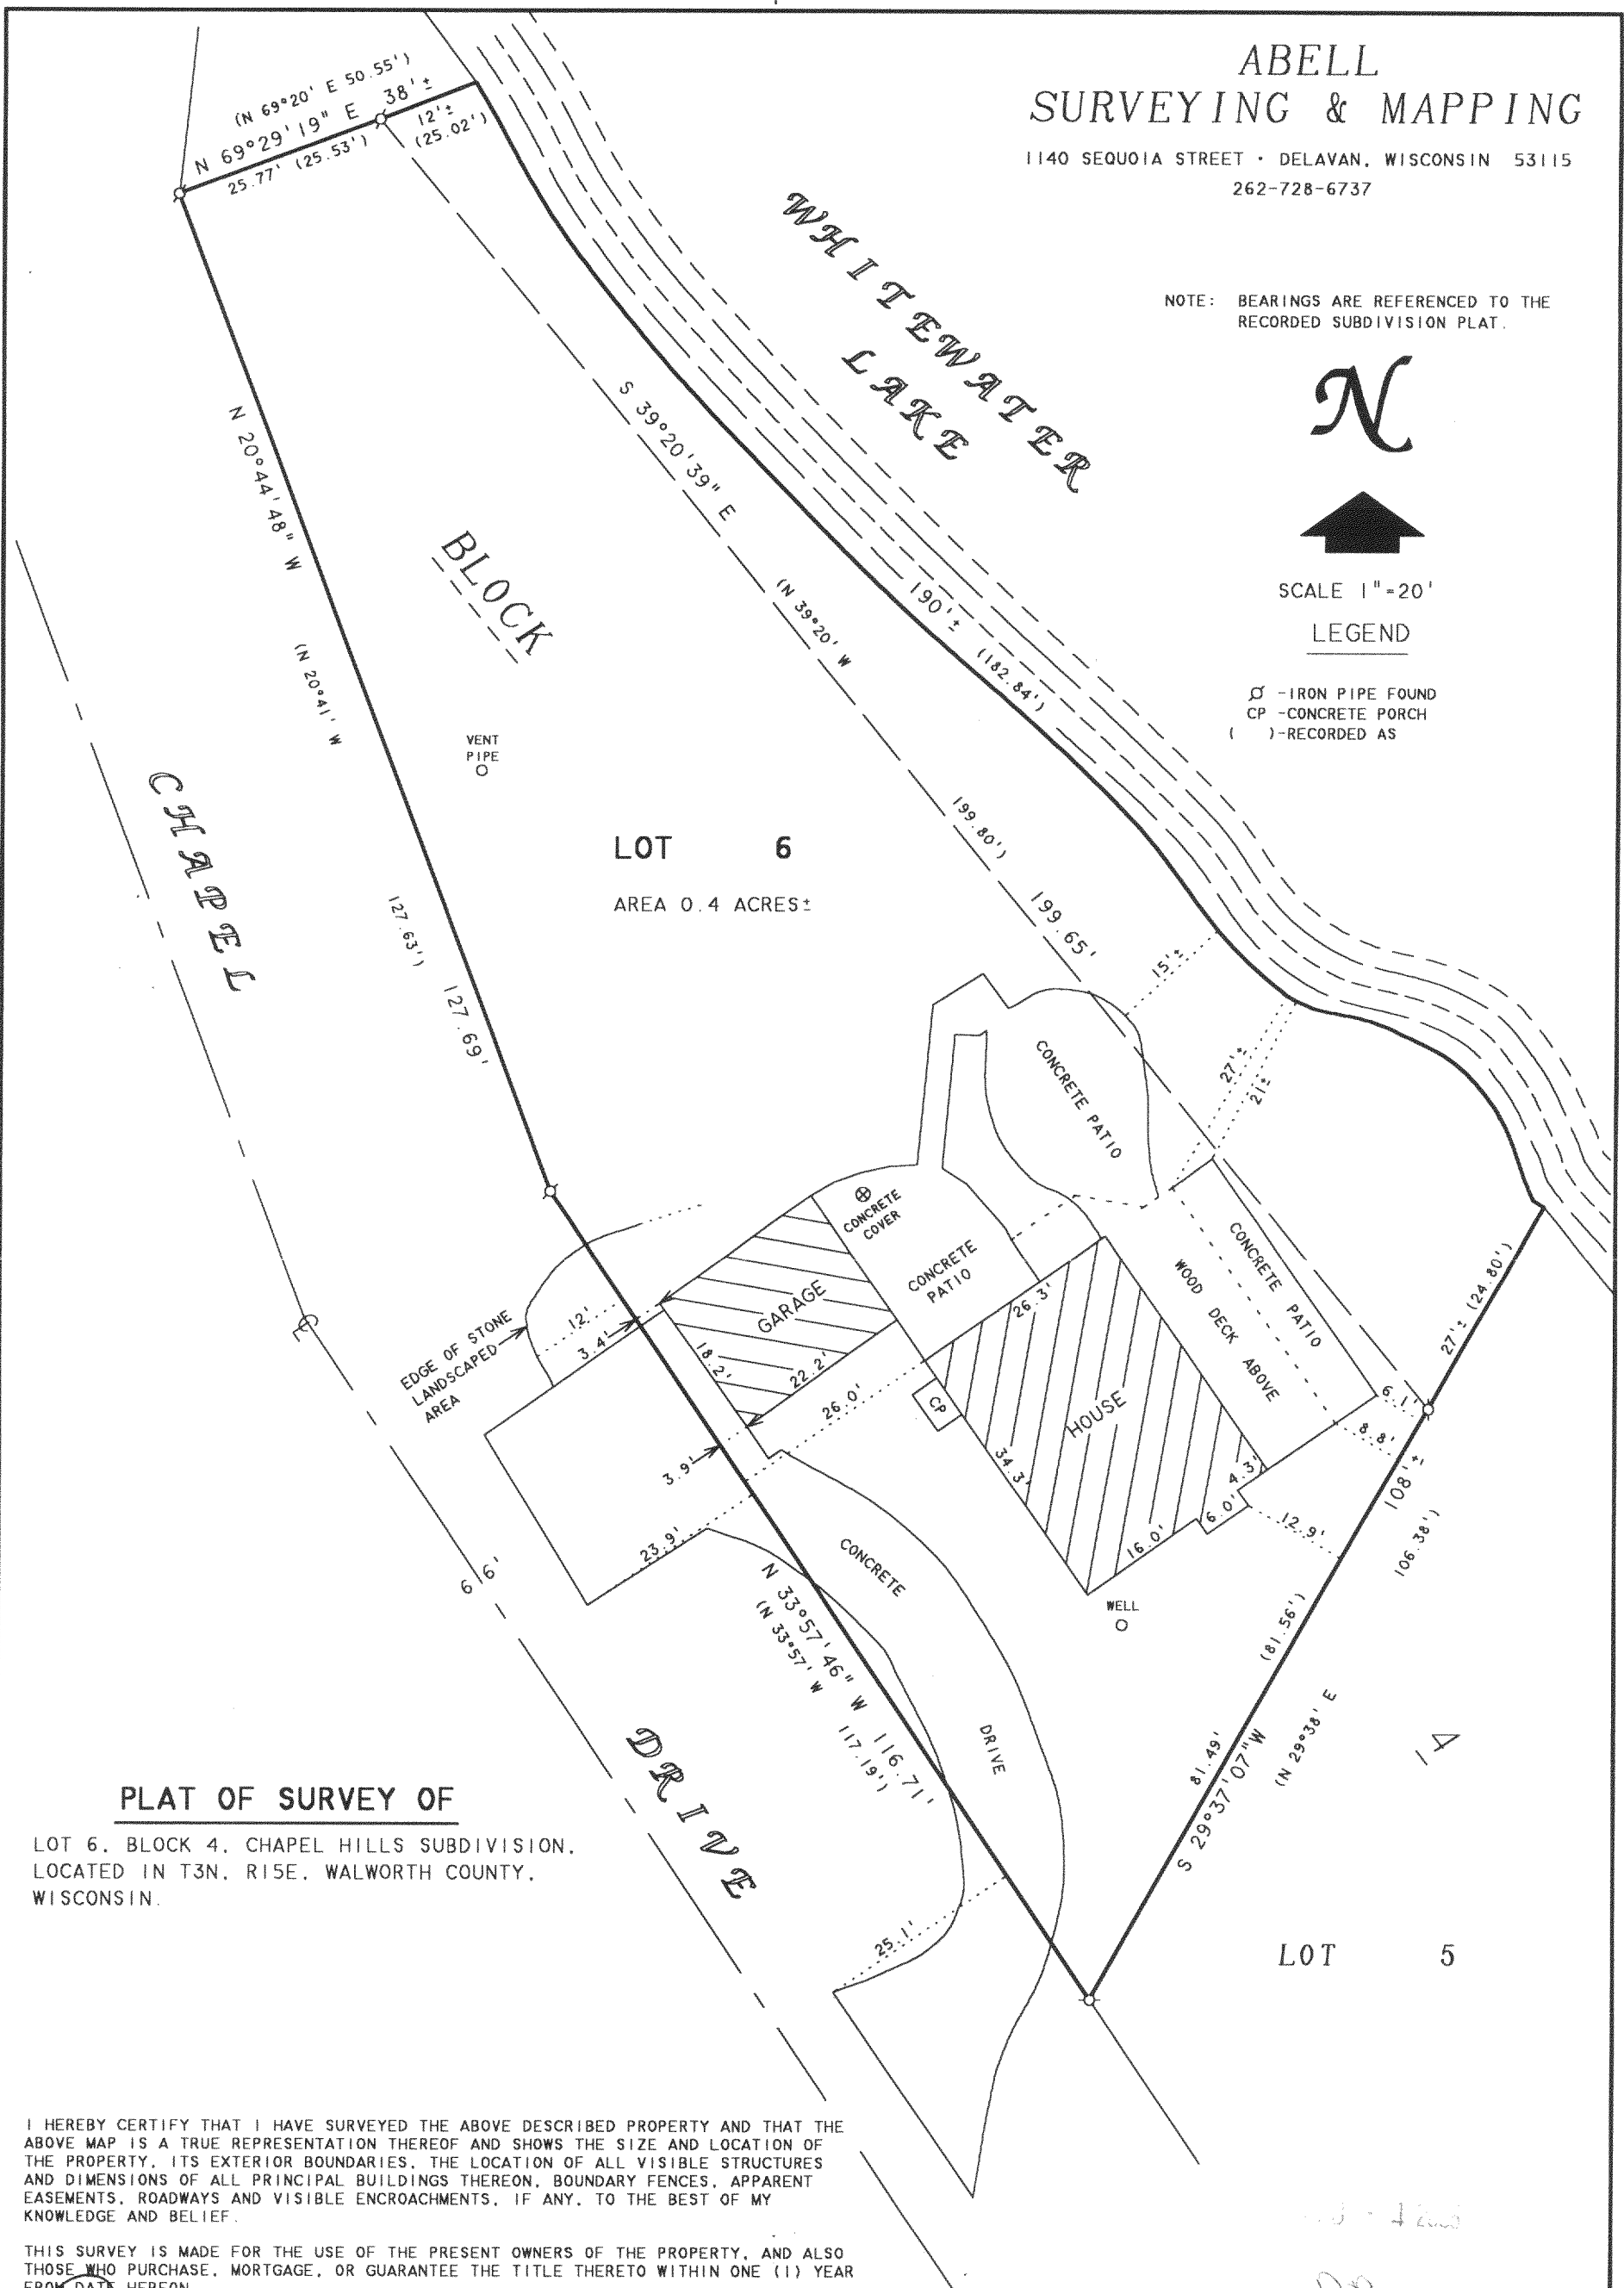

CCH-11

315-898