

LAND-MARK SURVEYING

Mark L. Miritz



Wisconsin Registered Land Surveyor S-2582

N9330 Knuteson Drive
Whitewater, WI 53190
Phone: (262) 495-3284
FAX : (262) 495-8421
LAND-MARKSURVEYING.COM

PLAT OF SURVEY

LOTS 11 - 16 INCLUSIVE OF BLOCK 6 OF
SKANSEN'S 1ST ADDITION SUBDIVISION,
LOCATED IN SECTION 9, TOWN 3 NORTH,
RANGE 15 EAST, WALWORTH COUNTY,
WISCONSIN.

OWNERS: ANTHONY J. STENZEL
MARY E. STENZEL
125 CONKEY STREET
BURLINGTON, WI 53105

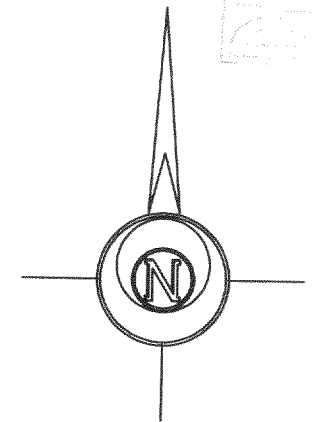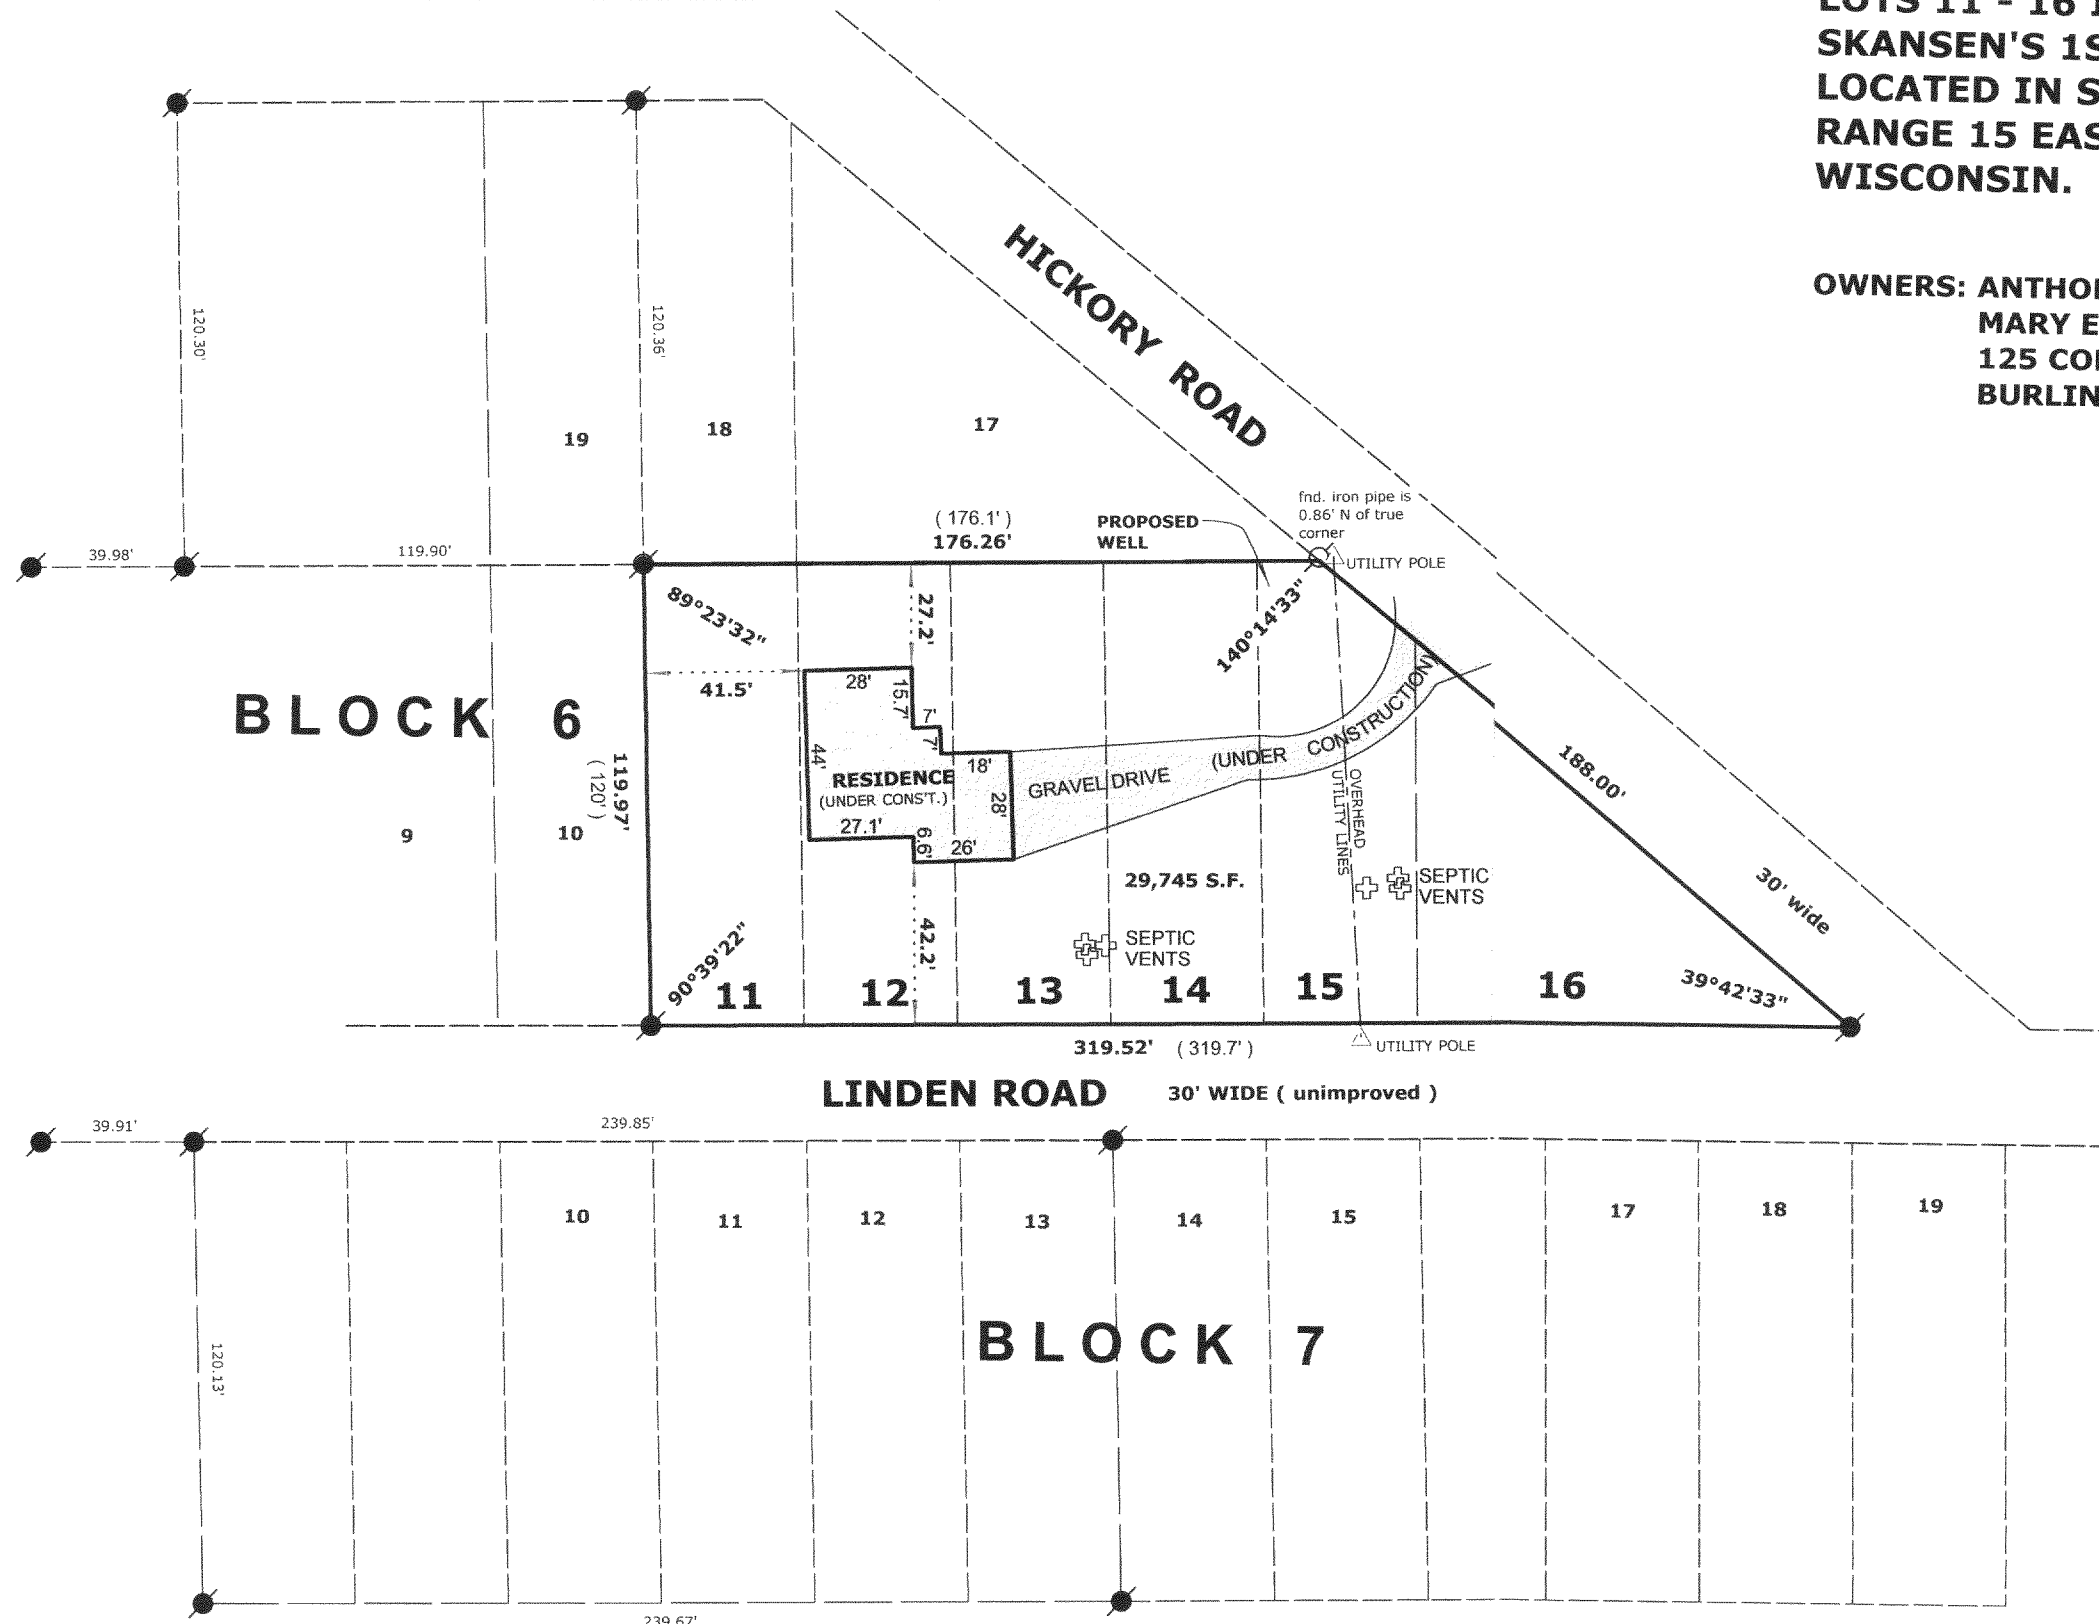

LEGEND

- FOUND IRON PIPE
- FOUND IRON ROD
- FOUND COUNTY MONUMENT
- FOUND CONCRETE MONUMENT
- CHISEL CUT IN CONCRETE
- SET IRON ROD, 24" LONG, WEIGHING 1.5 LBS./LINEAL FT., 3/4" DIA.
- RECORDED AS DIMENSION
- EXISTING FENCE

SCALE: 1" = 50 FEET

"I hereby certify that the above described property has been surveyed by me or under my direction and that the above map is a true representation thereof and shows the size and location of the property, its exterior boundaries, the location of all visible structures and dimensions of all principal buildings thereon, boundary fences, apparent easements, roadways and visible encroachments, if any."

"This survey is made for the use of the present owners of the property, and also those who purchase, mortgage, or guarantee the title thereto within one year from date hereof."



Mark L. Miritz
MARK L. MIRITZ
WISCONSIN REGISTERED
LAND SURVEYOR S-2582

REVISED NOV. 24, 2005 TO SHOW RESIDENCE "AS BUILT" DATE: JUNE 28, 2005 JOB NO. 05.621

CSA-94

315-951