SURVEY DATE: 02/07/07 SURVEY MADE FOR: WATERVIEW LODGE, LLC 160 W HONEYSUCKLE RD LAKE FOREST IL 60045

146 E. MILWAUKEE ST. IEFFERSON, WI 53549 (920) 674-3411 THIS SURVEY IS MADE FOR THE USE OF THE PRESENT OWNERS OF THE PROPERTY, AND ALSO THOSE WHO PURCHASE, MORTGAGE OR GUARANTEE TITLE TO WITHIN ONE (1) YEAR FROM DATE HERETO.

I, RANDAL K. WELTZIN R.L.S. \$1848, HEREBY CERTIFY THAT THIS SURVEY WAS MADE IN ACCORDANCE WITH THE MINIMUM STANDARDS FOR PROPERTY SURVEYS (CHAPTER A-E 7) FOR THE STATE OF WISCONSIN AND HAS BEEN PREPARED UNDER MY DIRECTION AND CONTROL AND IS CORRECT TO THE BEST OF MY KNOWLEDGE AND BELIEF.



RECERTIFICATION OF **BUILDING LOCATION**

DESCRIPTION:

LOT 4. CLIFF'S VIEW SUBDIVISION, LYING IN PART OF THE NORTHEAST 1/4 OF THE NORTHWEST 1/4 OF SECTION 3. TOWNSHIP 3 NORTH, RANGE 15 EAST, TOWN OF WHITEWATER, WALWORTH COUNTY, WISCONSIN.

FEB | 4 2007

AREA:


4.15 ACRES TO MEANDER LINE 4.37 ACRES TO SHORELINE

NOTE:

CONTOURS DRAWN FROM PLAT OF SURVEY MADE BY, PETER S. GORDON, S-2101, FARRIS, HANSEN AND ASSOCIATES, 7 RIDGEWAY COURT, ELKHORN, WISCONSIN. DATED OCTOBER 7, 2005. MEAN SEA

(33.00') RECORDED DISTANCE 33.00 MEASURED DISTANCE ¾" FOUND IRON ROD FOUND SPIKE **SB** SOIL BORING LOCATION

LEGEND

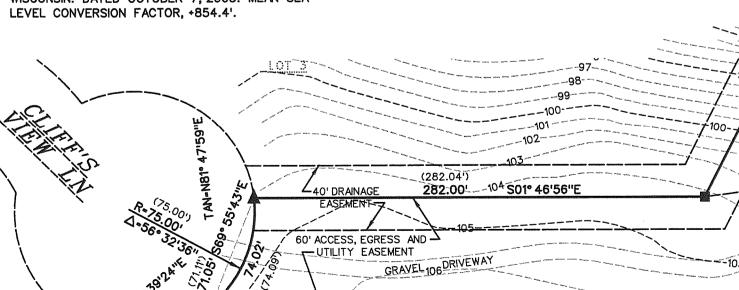

PROPERTY BOUNDARY OF LOT 4 WAS TAKEN TO BEAR NO1° 46'56"W CLIFF'S VIEW SUBDIVISION LOT 3

686.39' N01° 46'48"W

(686,501)

WHITEWATER LAKE SHORELINE AUG. 2, 2006 BASIS OF BEARING: THE WESTERLY **OSB** S LOT CONDER HOUSE 2. E. S. S. E. C. TIONY 65 LOT 5 BUILDING SETBACK PROPOSED PAVEMENT 102 ACCESS, EGRESS AND UTILITY EASEMENT-**EBDIVSION** (WIDTH VARIES)

RSV JOB*: 06-557 WATERVIEW LODGE NAME: Z:\CADD 2006\06557 WATERVIEW LODGE SURV\RECERT\SHT RECERT.DGN

UNPLATTED LANDS