

LAND-MARK SURVEYING

Mark L. Miritz


Wisconsin Registered Land Surveyor S-2582

N9330 Knuteson Drive
Whitewater, WI 53190
Phone: (262) 495-3284
FAX : (262) 495-8421
LAND-MARKSURVEYING.COM

PLAT OF SURVEY


LOT 2 OF CERTIFIED SURVEY MAP NO.
3777, LOCATED IN THE SOUTHWEST
1/4 OF THE SOUTHEAST 1/4 OF
SECTION 2, TOWN 3 NORTH, RANGE 15
EAST, RICHMOND TOWNSHIP,
WALWORTH COUNTY, WISCONSIN

OWNER: VERA HELLING BROOKS LIVING TRUST
W7864 TERRITORIAL ROAD
DELAVAN, WI. 53115

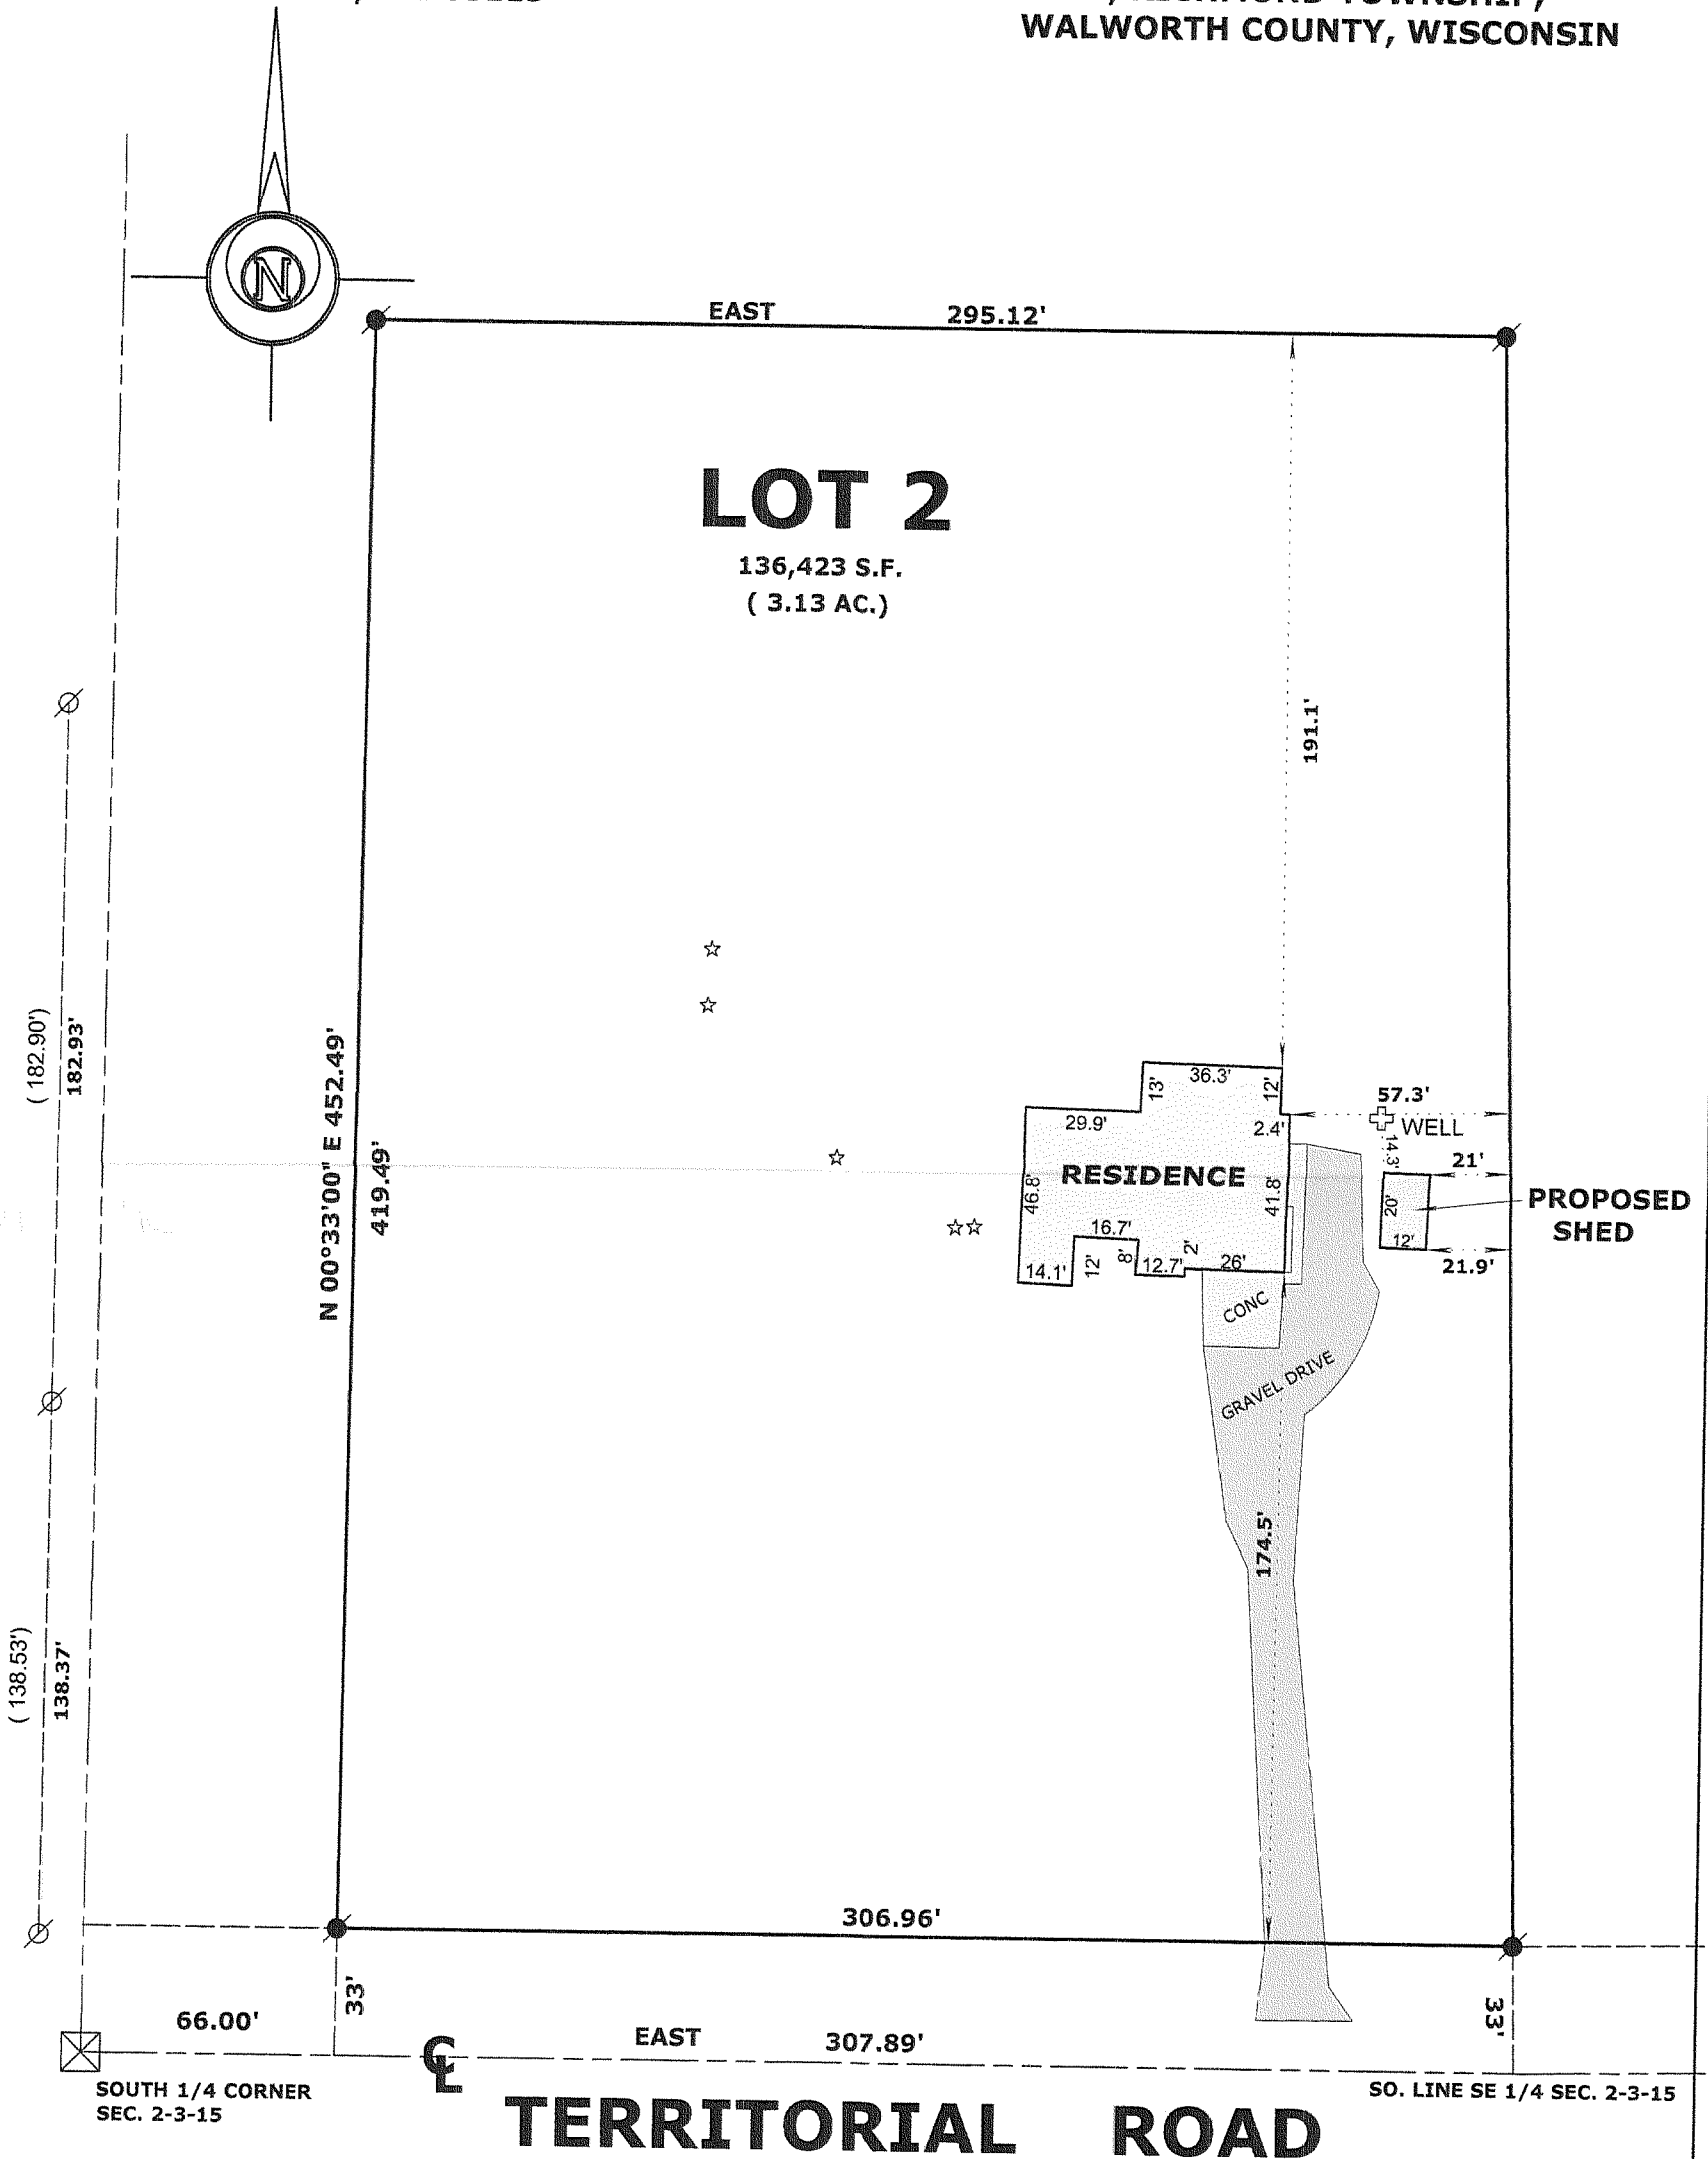

LEGEND

- ⊗ FOUND IRON PIPE
- FOUND IRON ROD
- ⊠ FOUND COUNTY MONUMENT
- ☆ SEPTIC
- + CHISEL CUT IN CONCRETE
- SET IRON ROD, 24" LONG, WEIGHING 1.5 LBS./LINEAL FT., 3/4" DIA.
- (x x) RECORDED AS DIMENSION
- x — x — EXISTING FENCE

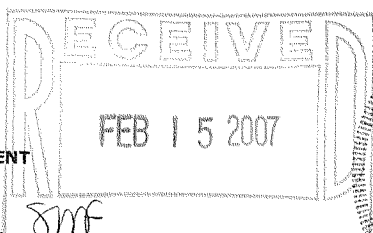

SCALE: 1" = 50 FEET

"I hereby certify that the above described property has been surveyed by me or under my direction and that the above map is a true representation thereof and shows the size and location of the property, its exterior boundaries, the location of all visible structures and dimensions of all principal buildings thereon, boundary fences, apparent easements, roadways and visible encroachments, if any."

"This survey is made for the use of the present owners of the property, and also those who purchase, mortgage, or guarantee the title thereto within one year from date hereof."

MARK L. MIRITZ
WISCONSIN REGISTERED
LAND SURVEYOR S-2582

DATE: DEC. 2, 2006 JOB NO. 05.203

CA3777-2

3/5-1008