


**ABELL  
SURVEYING & MAPPING**

1140 SEQUOIA STREET • DELAVAN, WISCONSIN 53115  
262-728-6737



BEARINGS ARE REFERENCED TO CERTIFIED SURVEY MAP NO. 2147, THE SOUTH LINE OF THE SOUTHWEST 1/4 OF SECTION 35, T3N, R15E, IS ASSUMED EAST-WEST.

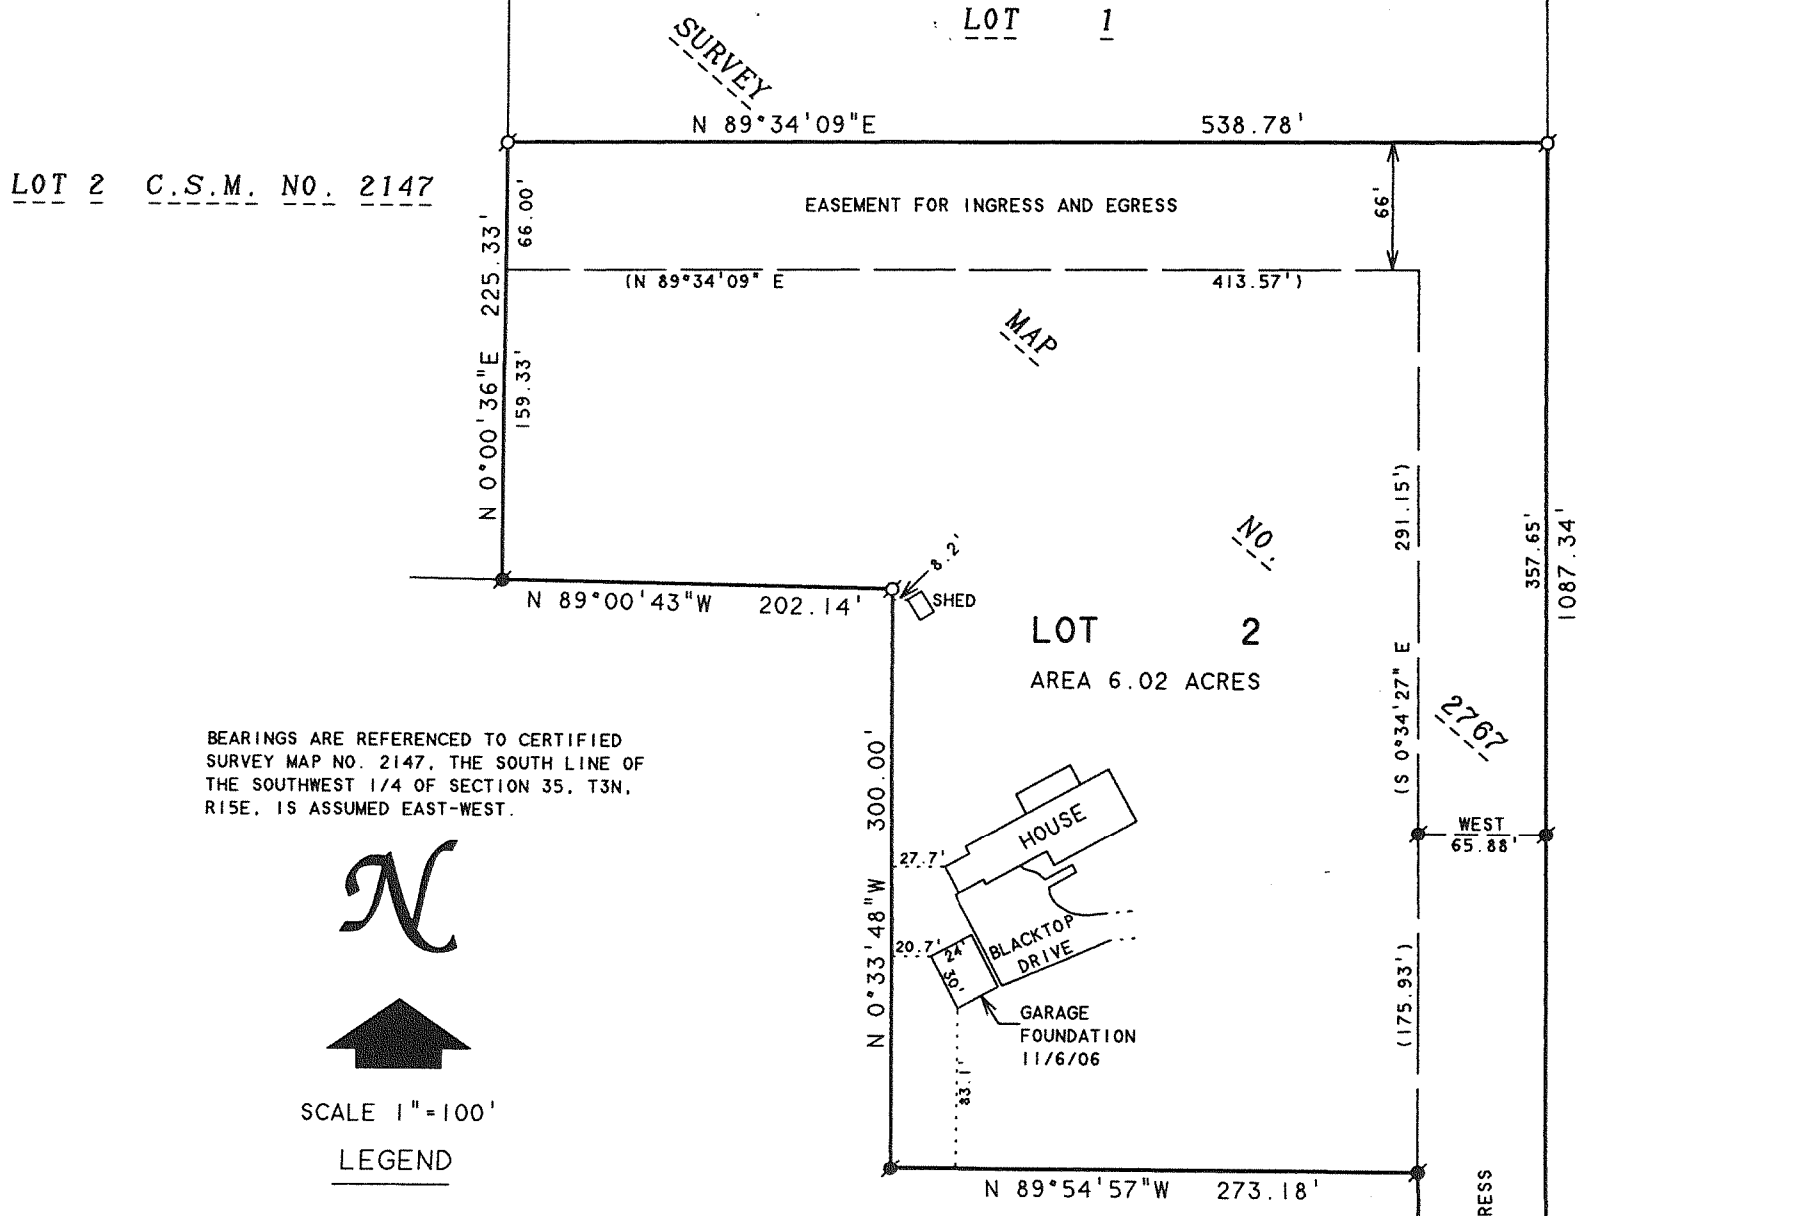


SCALE 1" = 100'

**LEGEND**


- -WALWORTH COUNTY CONCRETE MONUMENT WITH BRASS CAP FOUND
- -IRON ROD FOUND
- -IRON PIPE FOUND
- ( ) -RECORDED AS

NOTE: THIS PLAT WAS PREPARED TO OBTAIN A ZONING/BUILDING PERMIT FOR THE PROPOSED GARAGE ONLY.

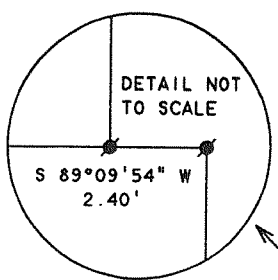

**PLAT OF SURVEY OF**

LOT 2, CERTIFIED SURVEY MAP NO. 2767, LOCATED IN THE SOUTHEAST 1/4 AND IN THE NORTHEAST 1/4 OF THE SOUTHWEST 1/4 OF SECTION 35, T3N, R15E, WALWORTH COUNTY, WISCONSIN.

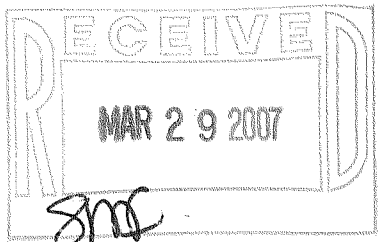

**R & D  
TOWNLIN E ROAD**

I, DAVID F. ABELL, DO HEREBY CERTIFY THAT I HAVE SURVEYED THE PROPERTY HEREON DESCRIBED ACCORDING TO THE OFFICAL RECORDS AND THAT THE PLAT HEREON IS A CORRECT REPRESENTATION OF THE PROPERTY LINES TO THE BEST OF MY KNOWLEDGE AND BELIEF.

*David F. Abell*

DAVID F. ABELL  
WISCONSIN REGISTERED LAND SURVEYOR, S-1596

October 17, 2006

DATE: \_\_\_\_\_ JOB NUMBER - 06096A

NOTE: THIS IS NOT A CERTIFIED COPY UNLESS SEALED.

ORDERED BY: STEVE ANDERSON  
W7908 R & D TOWNLIN E ROAD  
DELAVAN, WI 53115

REVISED: NOVEMBER 6, 2006 TO SHOW THE GARAGE FOUNDATION.

CA2707-2

315-1015