

# FARRIS, HANSEN & ASSOCIATES, INC.

ENGINEERING — ARCHITECTURE — SURVEYING  
7 RIDGWAY COURT — P.O. BOX 437 — ELKHORN, WISCONSIN 53121  
PHONE: (262) 723-2098 FAX: (262) 723-5886

## PLAT OF SURVEY OF

### 5. The land referred to in this Commitment is described as follows:

Lot 1 of Certified Survey Map No. 205, recorded in the Office of the Register of Deeds for Walworth County, Wisconsin on January 31, 1973 in Volume 1 of Certified Maps, Page 205, as Document No. 660496, being located in the Northeast Quarter of Section 30, Township 3 North, Range 15 East, Town of Richmond, Walworth County, Wisconsin.

**Purported Address:**  
n5575 Delaney Road  
Richmond, Wisconsin

### LEGEND

- — UTILITY POLE
- — UTILITY PEDESTAL
- — FOUND IRON PIPE STAKE
- (XXX) — RECORDED AS
- ⊙ — VENT PIPE FOR SEPTIC

ORDERED BY: DALE REED  
3745 STATE RD 67  
ELKHORN, WISCONSIN  
53121




NOTE "A"  
EASEMENT REC. IN VOL. 250, PG. 208, AS DOC. 325244  
ALLOWS FOR POWER POLES AND WIRES TO BE RUN  
ALONG THE WEST SIDE OF THE HIGHWAY. NO EASEMENT  
WIDTH OR SPECIFIC LOCATION GIVEN.

NOTE: COPIES OF THIS MAP TO WHICH THE FOLLOWING CERTIFICATE WILL  
APPLY SHOW SURVEYOR'S ORIGINAL SEAL AND SIGNATURE IN RED INK. COPIES  
BY ANY OTHER MEANS MAY HAVE ALTERATIONS WHICH DO NOT REPRESENT THE  
SURVEYOR'S WORK PRODUCT.


I HEREBY CERTIFY THAT THE ABOVE DESCRIBED PROPERTY HAS BEEN SURVEYED  
UNDER MY DIRECTION AND THAT THE ABOVE MAP IS A TRUE REPRESENTATION  
THEREOF AND SHOWS THE SIZE AND LOCATION OF THE PROPERTY, ITS EXTERIOR  
BOUNDARIES, THE LOCATION OF ALL VISIBLE STRUCTURES, AND DIMENSIONS OF  
ALL PRINCIPLE BUILDINGS THEREON, BOUNDARY FENCES, APPARENT EASEMENTS,  
ROADWAYS, AND VISIBLE ENCROACHMENTS, IF ANY. THIS SURVEY IS MADE FOR  
THE USE OF THE PRESENT OWNERS OF THE PROPERTY, AND ALSO THOSE WHO  
PURCHASE, MORTGAGE, OR GUARANTEE THE TITLE THERETO WITHIN ONE YEAR  
FROM THE DATE HEREOF.

DATED: DECEMBER 5, 2008

*Peter S. Gordon*  
PETER S. GORDON R.L.S. 2101

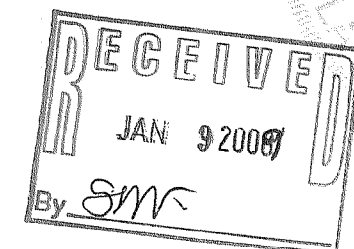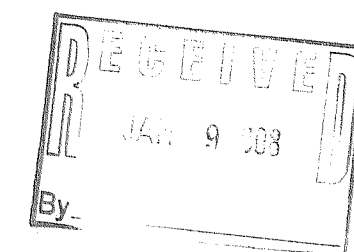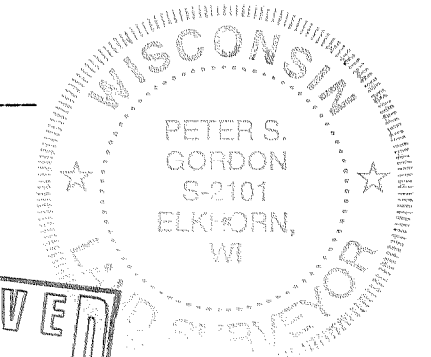

PROJECT: 7802  
DATE: 11-25-2008  
SHEET 1 OF 1

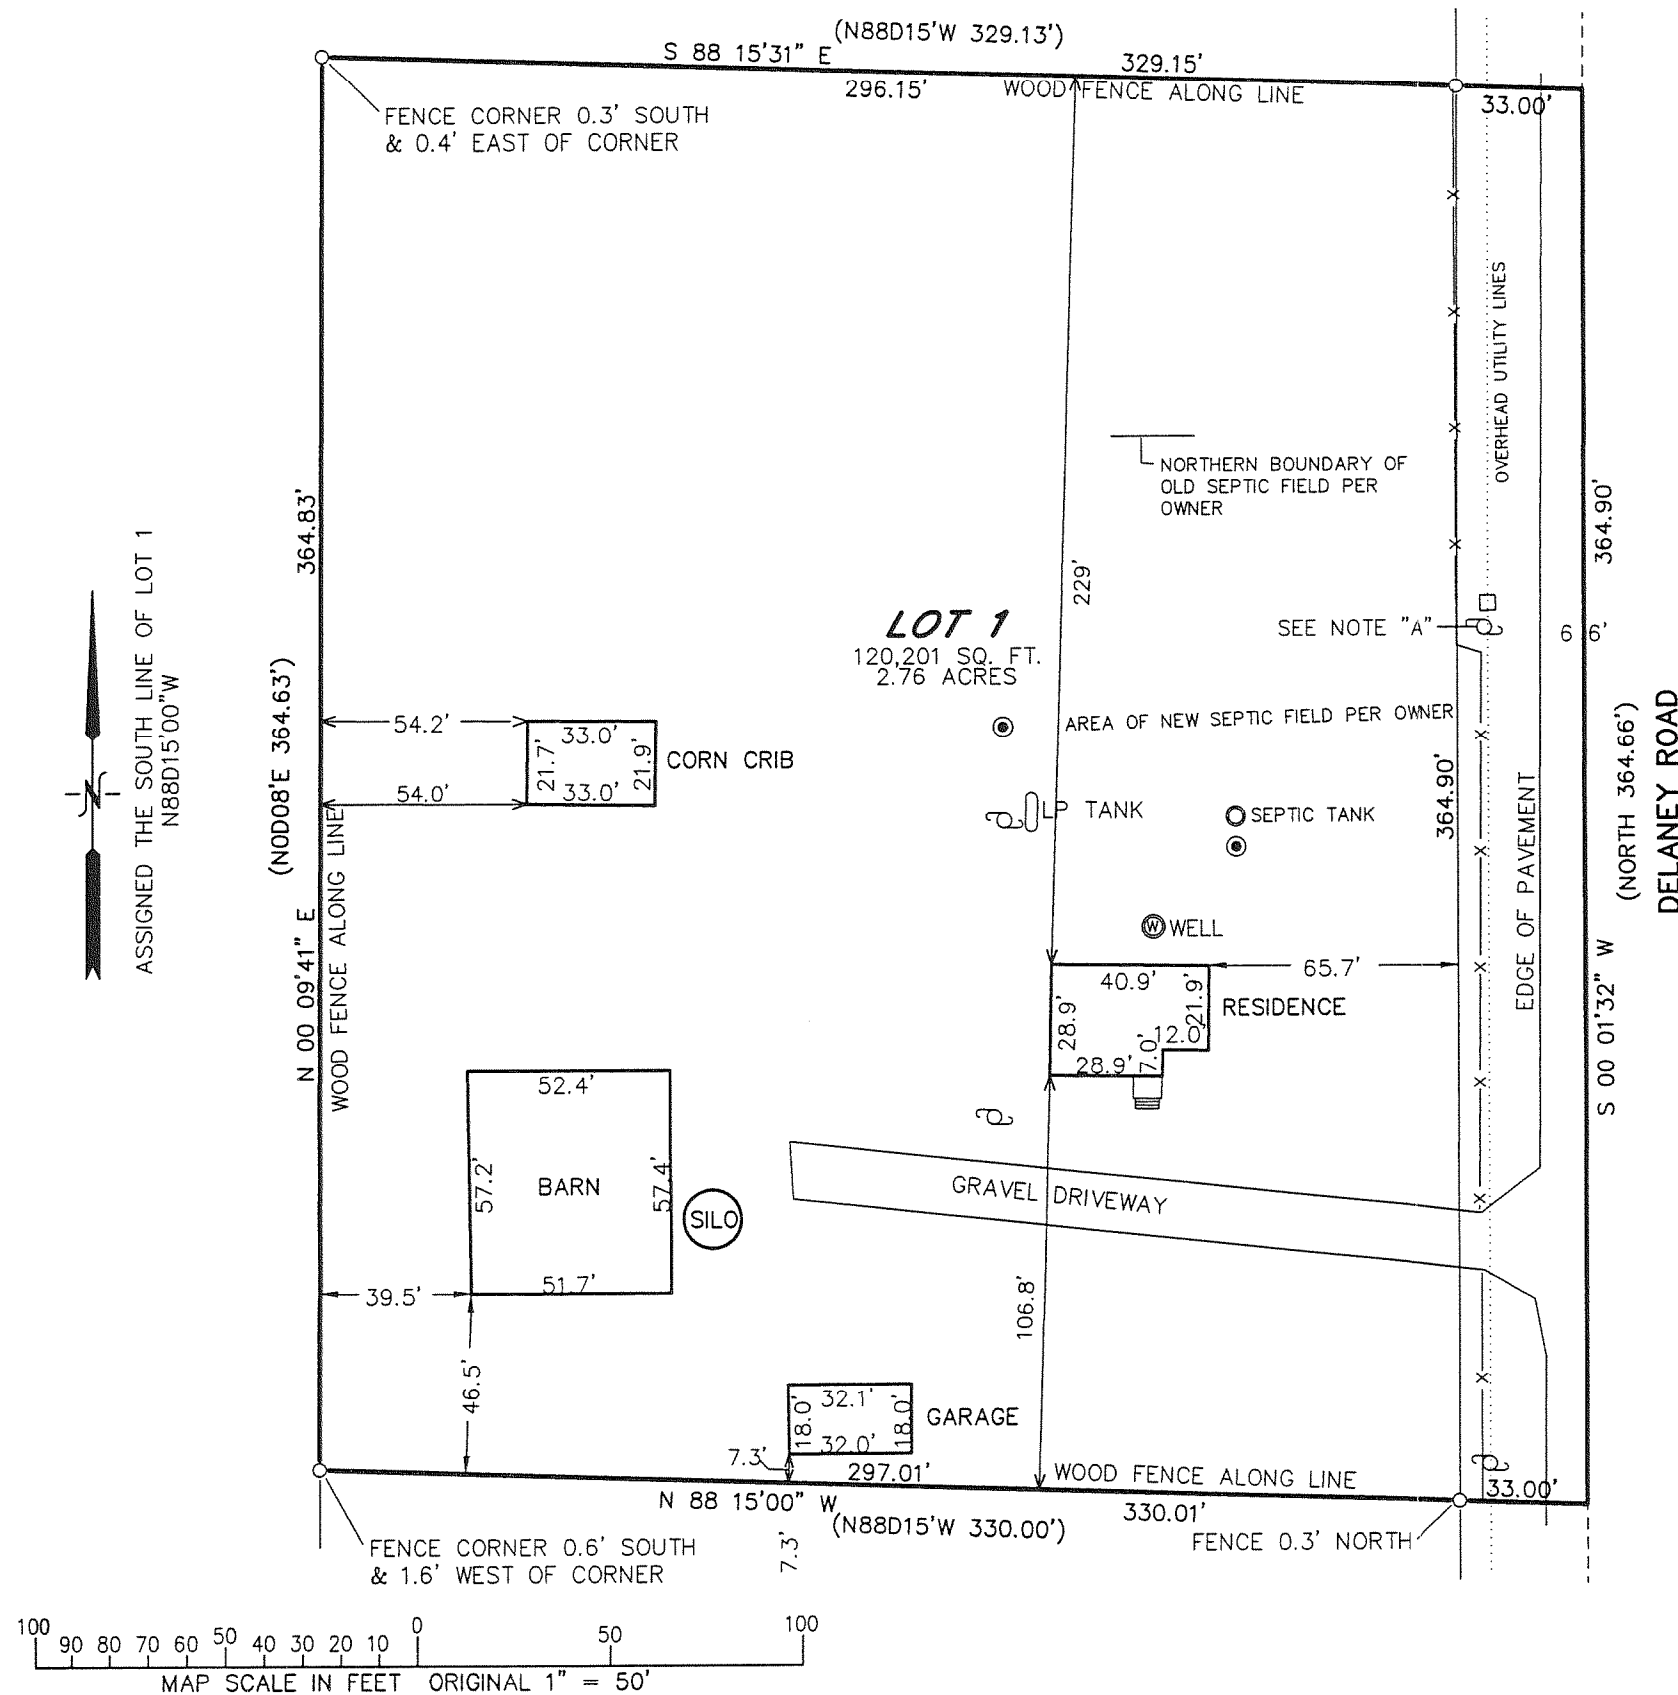

100 90 80 70 60 50 40 30 20 10 0 50 100  
MAP SCALE IN FEET ORIGINAL 1" = 50'

CA205-1

315-1082