
NO DIMOCON

of 1 Sheets

2009.048

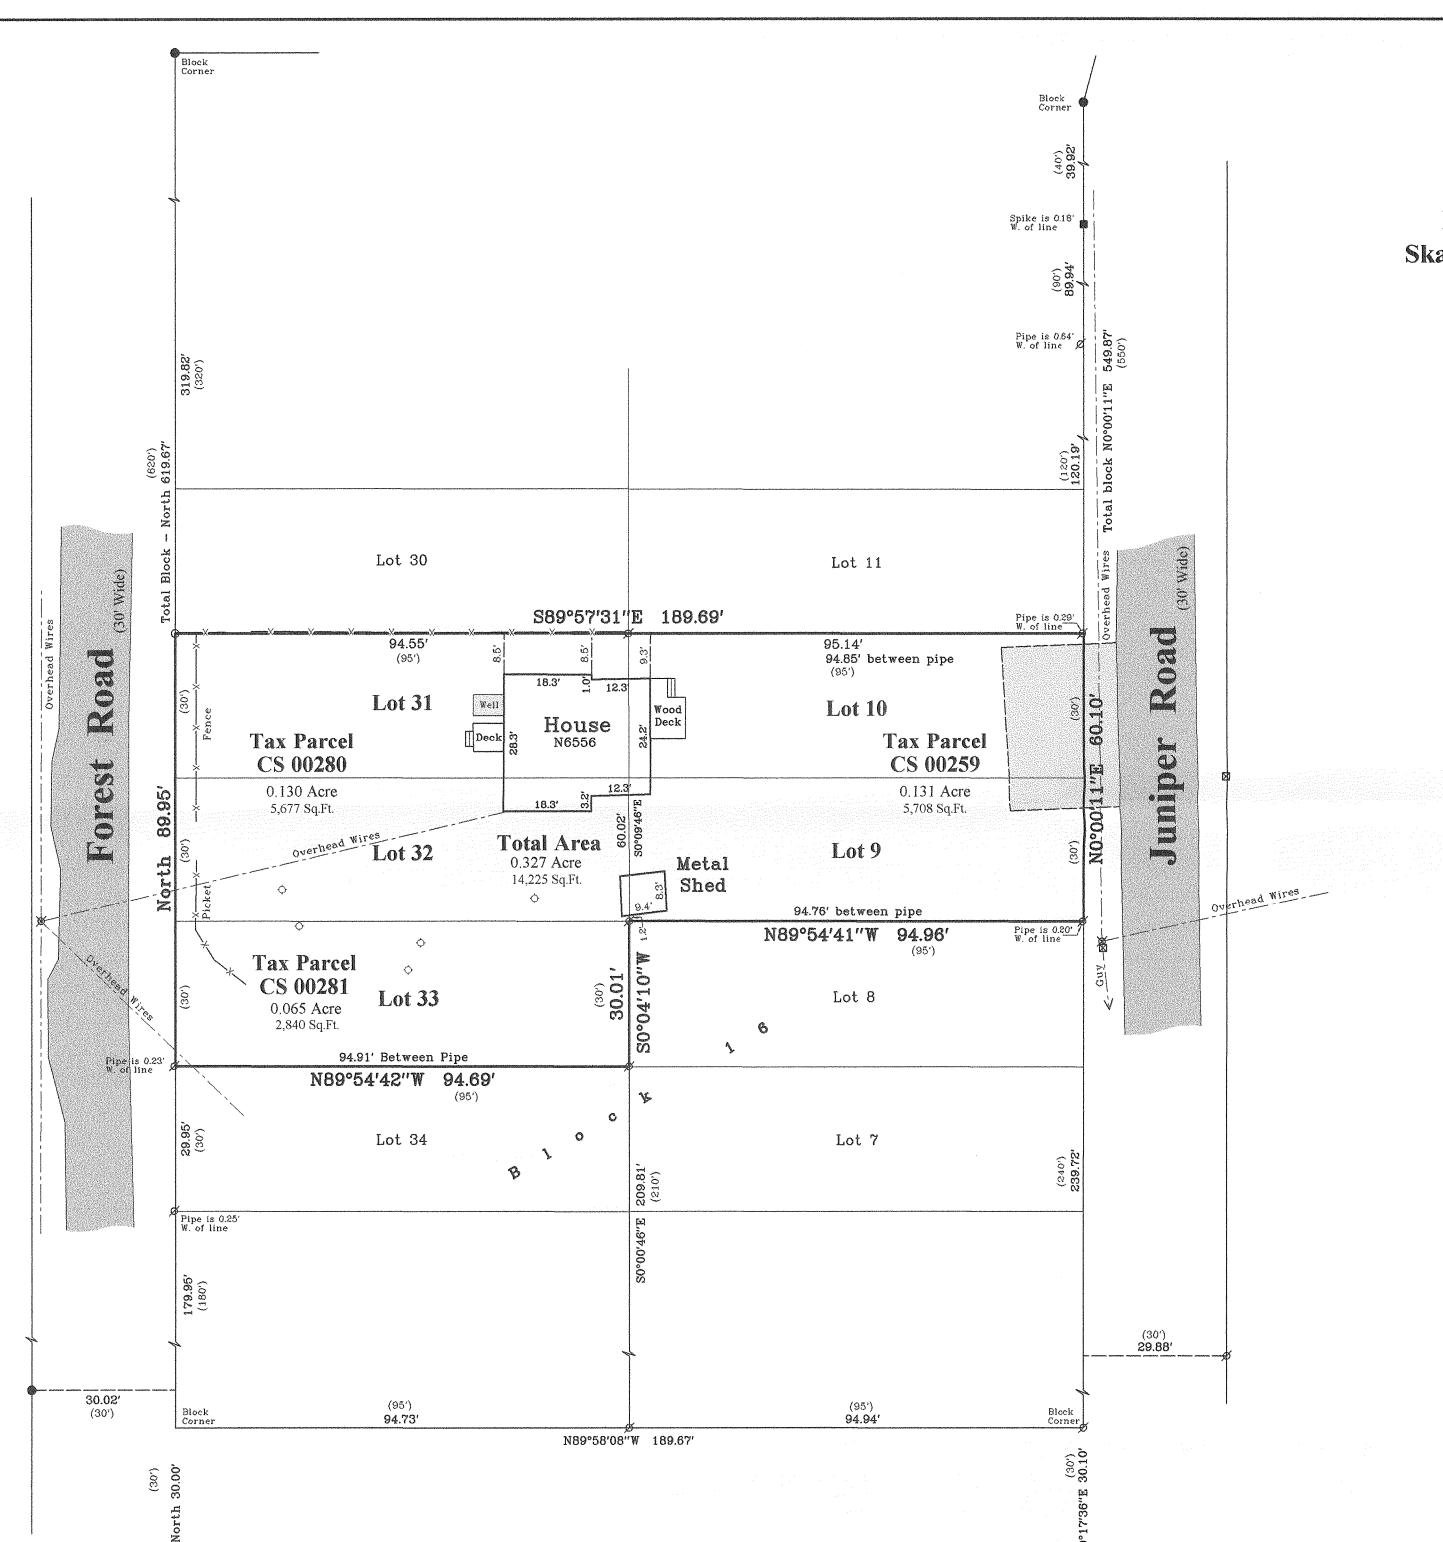

N89°56'23"W 189.83'


Plat of Survey

Lots 9, 10, 31, 32 and 33 in Block 16 of Skansen Swedish Tribune-News Subdivision,


located in the Southwest 1/4 of Section 9, Town 3 North, Range 15 East, Town of Richmond, Walworth County, Wisconsin.

Surveyed for: Matthew Lehmann


N6556 Forest Road Delavan, Wisconsin. 53115

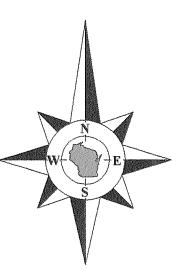

Bearings reference to the East line of Forest Road assumed to bear North.

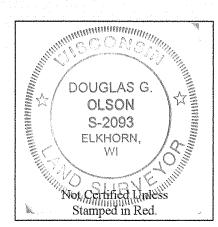

- 1) This survey plat is not certified unless signed and sealed in red ink.
- 2) This survey is subject to Wisconsin lien laws. This Plat of Survey is the notice of intent to file lien. Lien waiver required.

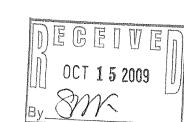

Copyright 2009 by Jensen & Olson Land Surveying, LLC.

All rights reserved. No part of this survey plat may be reproduced or transmitted in any form by any means - graphic, electronic, or mechanical, including photocopying, tracing, or information storage and retrieval systems - without permission in writing from Douglas G. Olson, Jensen & Olson Land Surveying, LLC.

I, Douglas G. Olson, Wisconsin Registered Land Surveyor, do hereby certify that this survey was performed by me, pr under my direction in full compliance with the owner's/agent's instructions and Chapter A-E 7 of the Wisconsin Administrative Code "Minimum Standards for Property Surveys"; and that this map is an accurate representation thereof to the best of my knowledge and belief.

> Douglas G. Olson Wisdonsln Registered Land Surveyor - 2093

CS-259 CS-280 CS-281

315-1100