


FARRIS, HANSEN & ASSOCIATES, INC.

ENGINEERING — ARCHITECTURE — SURVEYING
7 RIDGWAY COURT — P.O. BOX 437 — ELKHORN, WISCONSIN 53121
PHONE: (262) 723-2098 FAX: (262) 723-5886

PLAT OF SURVEY



LOT 5, BLOCK 6 OF CRYSTAL BOWL SUBDIVISION
LOCATED IN PART OF THE NE 1/4 OF THE NW 1/4 OF
SECTION 13, TOWN 3 NORTH, RANGE 15 EAST,
WALWORTH COUNTY, WISCONSIN

— WORK ORDERED BY —
RICHARD GRASS
204 BUTTE LANE
CARPENTERSVILLE, IL 60110

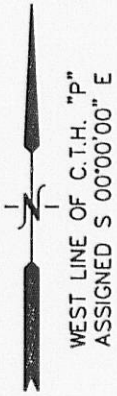

LEGEND

- = FOUND IRON REBAR STAKE
- ⦿ = SET IRON REBAR STAKE
- {XXX} = RECORDED AS
- [XXX] = PREVIOUSLY SURVEYED

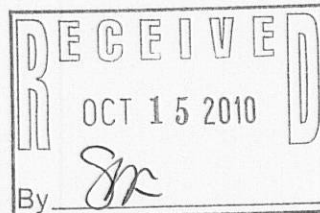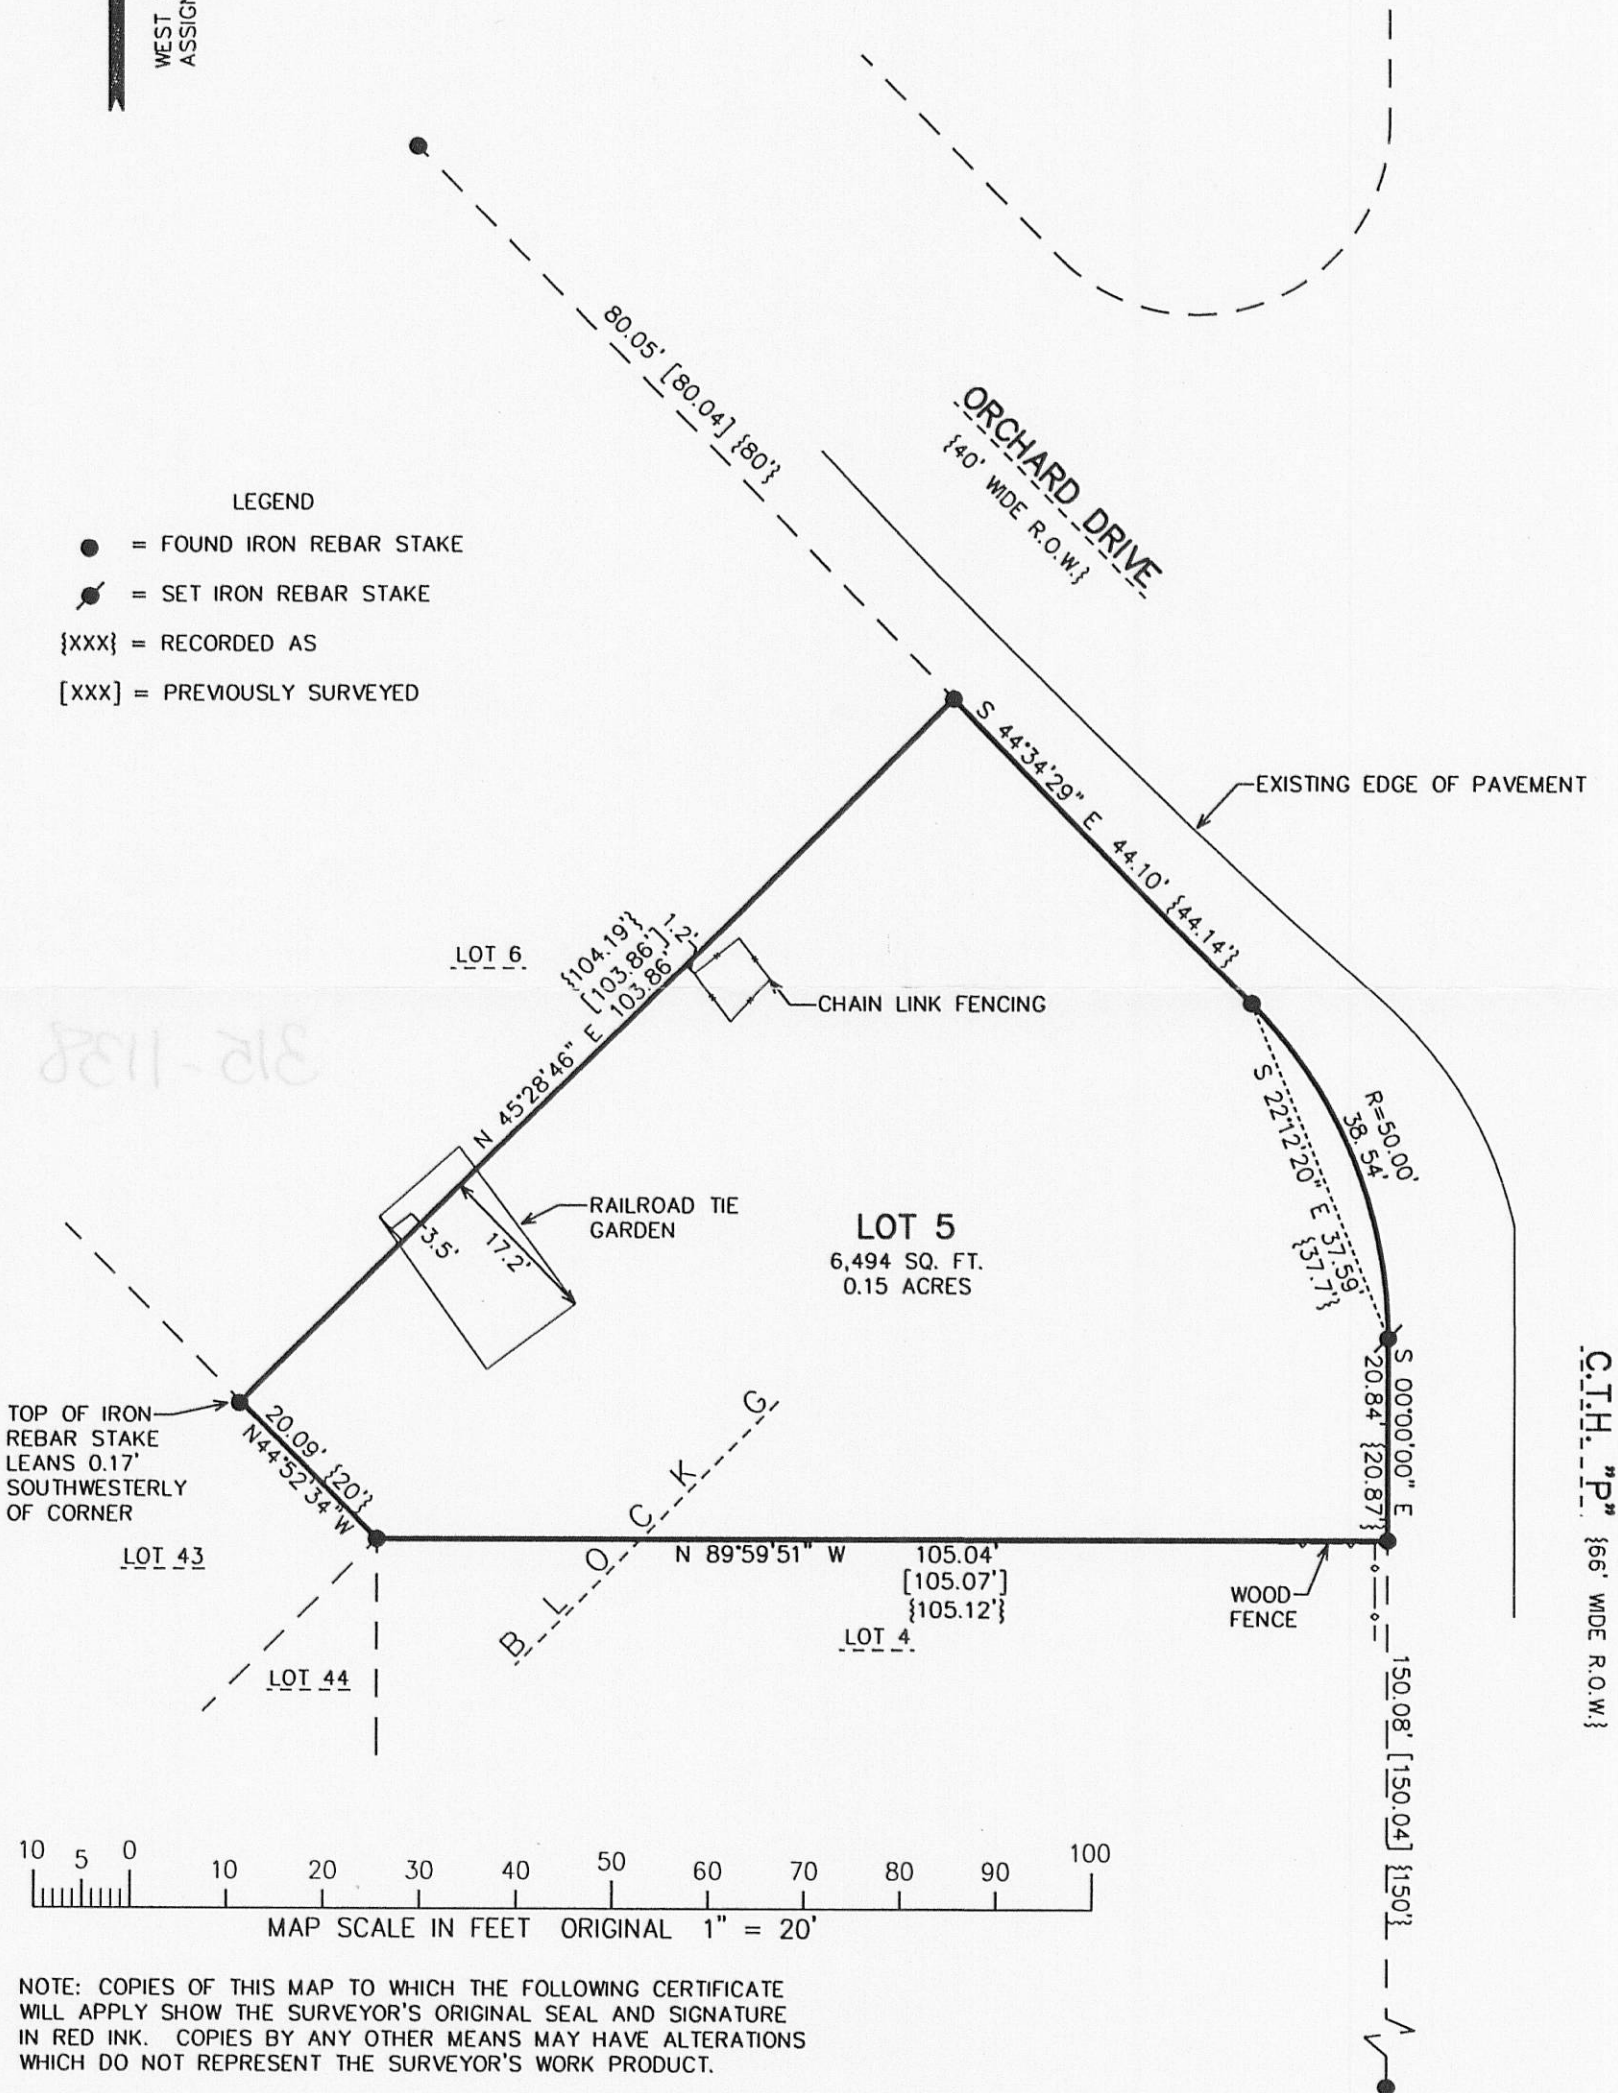

PROJECT: 8226
DATE: 9/14/2010
SHEET 1 OF 1