

FARRIS, HANSEN & ASSOCIATES, INC.

ENGINEERING – ARCHITECTURE – SURVEYING
 7 RIDGWAY COURT – P.O. BOX 437 – ELKHORN, WISCONSIN 53121
 PHONE: (262) 723-2098 FAX: (262) 723-5886

PLAT OF SURVEY

LOT 1 CSM 3025, REC. AS DOC. 394530
 LOCATED IN THE NW 1/4 OF THE SE 1/4 SEC. 15
 T3N, R15E, TOWN OF RICHMOND, WALWORTH COUNTY, WI.

ASSIGNED NORTH LINE NW 1/4 OF SE 1/4
 S 88°48'34" E

TURTLE LAKE ROAD

66' WIDE ROW

S 88°48'34" E
 239.86

N 01°15'03" E
 237.36

R=120.00
 C=144.03
 S 51°46'55" E
 155.03



NOTE: COPIES OF THIS MAP TO WHICH THE FOLLOWING CERTIFICATE WILL APPLY SHOW THE SURVEYOR'S ORIGINAL SEAL AND SIGNATURE IN RED INK. COPIES BY ANY OTHER MEANS MAY HAVE ALTERATIONS WHICH DO NOT REPRESENT THE SURVEYOR'S WORK PRODUCT.

I HEREBY CERTIFY THAT THE ABOVE DESCRIBED PROPERTY HAS BEEN SURVEYED UNDER MY DIRECTION AND THAT THE ABOVE MAP IS A TRUE REPRESENTATION THEREOF AND SHOWS THE SIZE AND LOCATION OF THE PROPERTY AND ITS EXTERIOR BOUNDARIES. THIS SURVEY IS MADE FOR THE USE OF THE PRESENT OWNERS OF THE PROPERTY, AND ALSO THOSE WHO PURCHASE, MORTGAGE, OR GUARANTEE THE TITLE THERETO WITHIN ONE YEAR FROM THE DATE HEREOF.



DATED: 9-26-1998

REVISED 2-21-2012
 TO SHOW SIZE &
 LOCATION OF PROPOSED
 RESIDENCE

PETER S. GORDON R.L.S. 2101


REVISED 05-17-2012
 TO SHOW AS BUILT RES.

LOT 1


229,415 S.F. EXCLUSIVE OF
 ROAD ROW (5.27 ACRES)

LEGEND

- = FOUND IRON REBAR STAKE
- (XXX) = RECORDED AS

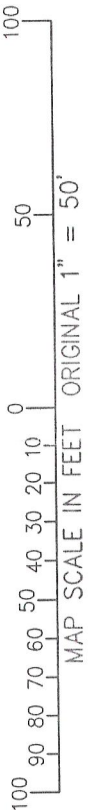

AS BUILT RESIDENCE & DECK

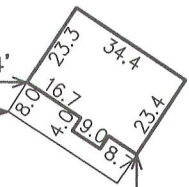

N 01°15'03" E
 306.19

190.3'

395.70
 N 88°45'58" W

540.20
 S 01°12'27" W

– WORK ORDERED BY –
 DIANE GILLESPIE
 1521 IROQUOIS AVE
 ST CHARLES, IL. 60174

PROJECT: 5770
 DATE: 02-21-2012
 SHEET 1 OF 1