
FARRIS, HANSEN & ASSOCIATES, INC.

ENGINEERING - ARCHITECTURE - SURVEYING 7 RIDGWAY COURT - P.O. BOX 437 - ELKHORN, WISCONSIN 53121 PHONE: (262) 723-2098 FAX: (262) 723-5886

PLAT OF SURVEY

LOTS 20 THUR 22 SKANSENS SUBDIVISION FIRST ADD. LOCATED IN THE NW 1/4 OF THE SW 1/4 SEC. 9 TOWN 3 NORTH, RANGE 15 EAST WALWORTH COUNTY, WISCONSIN

- WORK ORDERED BY -DONALD WAGNER N6631 FIR ROAD DELAVAN, WI. 53115

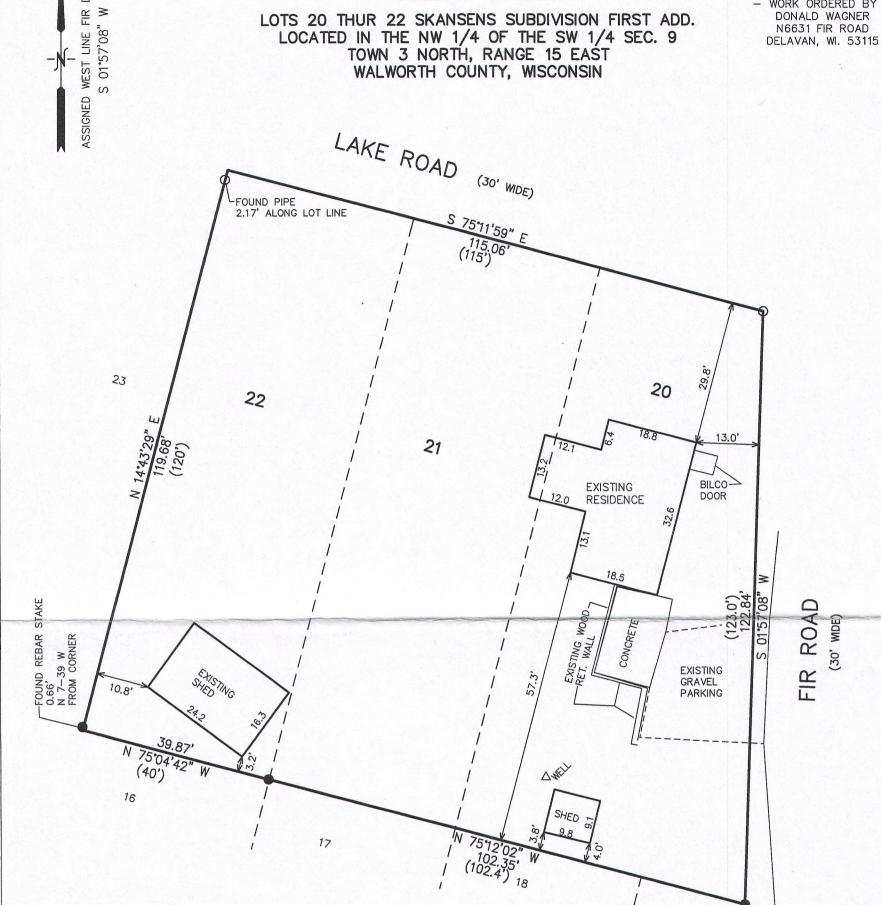

NOTE: COPIES OF THIS MAP TO WHICH THE FOLLOWING CERTIFICATE WILL APPLY SHOW THE SURVEYOR'S ORIGINAL SEAL AND SIGNATURE IN RED INK. COPIES BY ANY OTHER MEANS MAY HAVE ALTERATIONS WHICH DO NOT REPRESENT THE SURVEYOR'S WORK PRODUCT.

30

40

MAP SCALE IN FEET ORIGINAL 1" = 20'

I HEREBY CERTIFY THAT THE ABOVE DESCRIBED PROPERTY HAS BEEN SURVEYED UNDER MY DIRECTION AND THAT THE ABOVE MAP IS A TRUE REPRESENTATION THEREOF AND SHOWS THE SIZE AND LOCATION OF THE PROPERTY AND ITS EVERY AND SHOWS THE SIZE AND LOCATION OF THE PROPERTY AND ITS EXTERIOR BOUNDARIES. THIS SURVEY IS MADE FOR THE USE OF THE PRESENT OWNERS OF THE PROPERTY, AND ALSO THOSE WHO PURCHASE, MORTGAGE, OR GUARANTEE THE TITLE THERETO WITHIN ONE YEAR FROM THE DATE HEREOF.

DATED: FEBRUARY 2, 2016

10 5 0

lunlun

10

20

DRIVE

PETER S. GORDON P.L.S. 2101

LEGEND

= FOUND IRON PIPE STAKE

= FOUND IRON REBAR STAKE

(XXX) = RECORDED AS

19

OVERALL AREA = 15,405 S.F. 0.35 ACRES




100

80

70

60

90

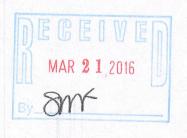

PROJECT: 9457 DATE: 02-02-2016 SHEET 1 OF 1

315-1250

X: \Projects\9457\DCAD\SURVEY 2/2/2016